


# T7N, RIOW, WM SEC 27

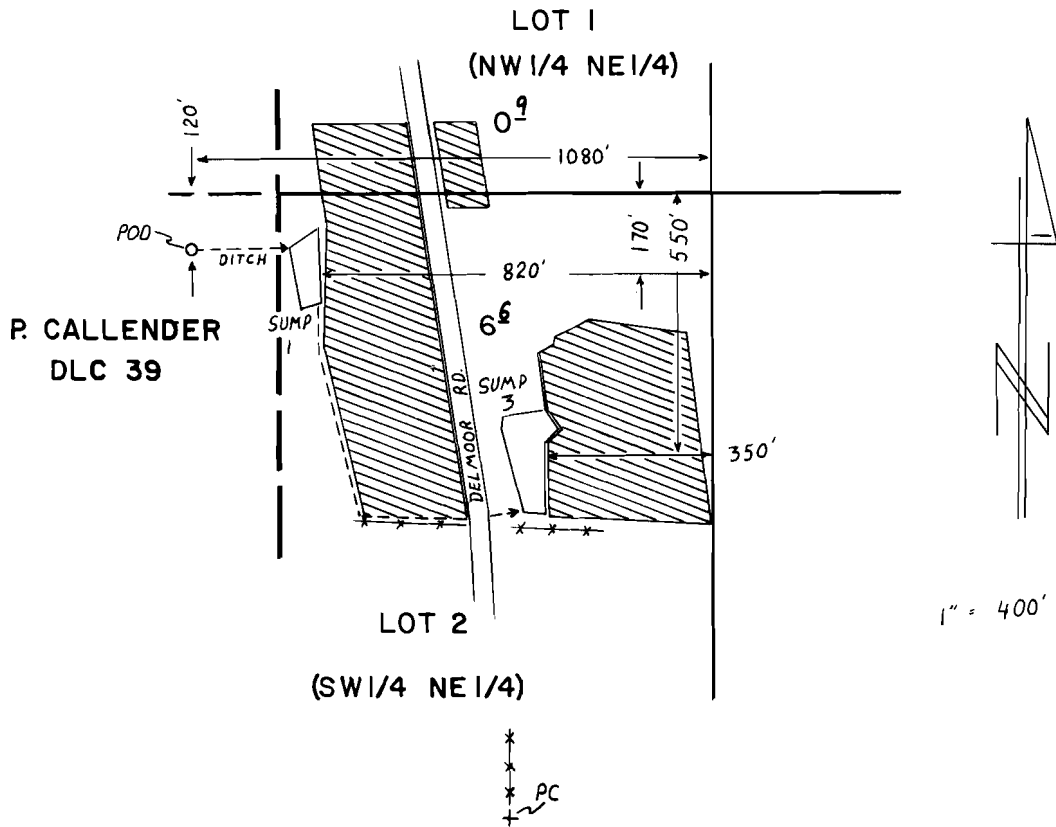

## FINAL PROOF SURVEY UNDER

G-10902                      G-10045  
 Application No. 49994    Permit No. 47470  
 IN NAME OF

.....RONALD E. KAINO.....

Surveyed JULY 19 1988, by T.M. WARREN..

RWK  
 PTS WFF