


T. 14 S., R. 5 W., W. M.

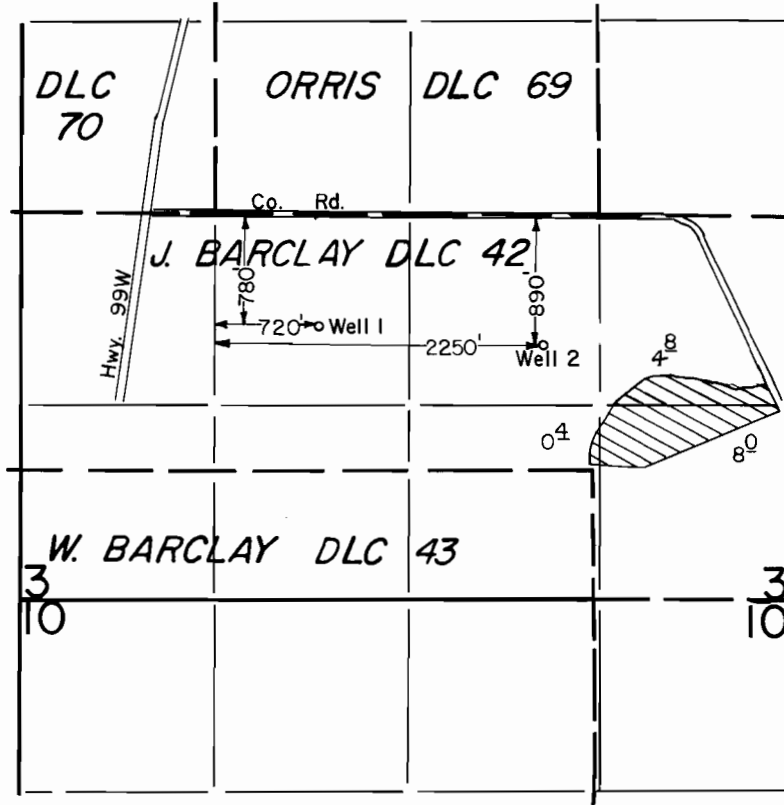

Scale: 1" = 1320'

FINAL PROOF SURVEY

UNDER

TRANSFER 5263

Application No. G-10961 Permit No. G-10147.....
IN NAME OF

DAVID BARCLAY

Surveyed Nov. 13 1987, by T. Warren.....