


T. 14S., R. 5W., W. M.

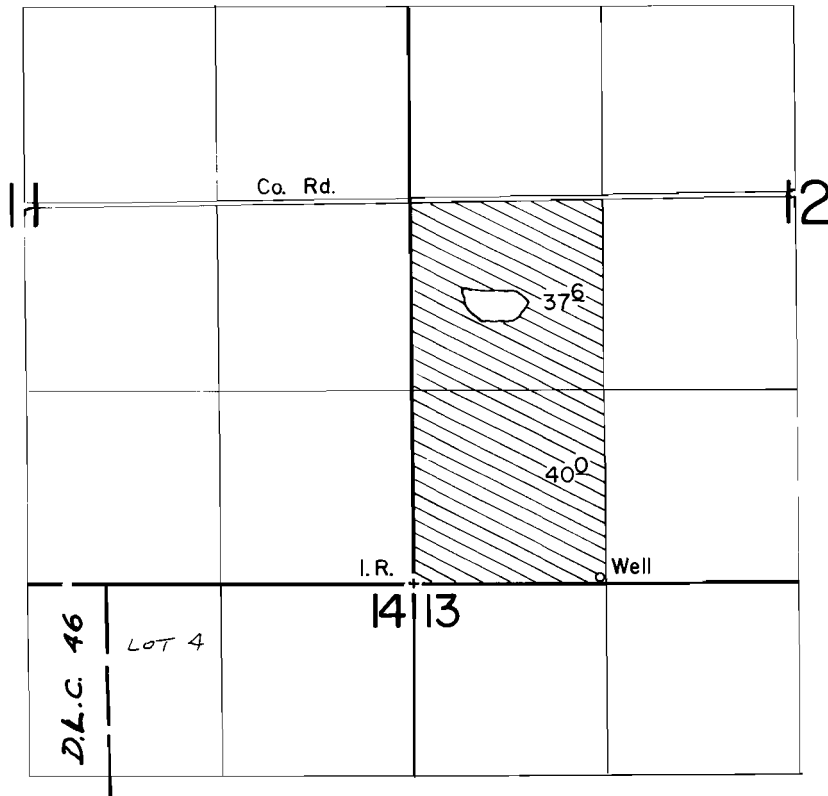

Well Loc.: 50' N. & 1280' E. from SW Cor. Sec. 12.

Scale: 1" = 1320'

FINAL PROOF SURVEY

UNDER

Application No. G-11068. Permit No. G-10217.....
IN NAME OF

DAVID BARCLAY

Surveyed Nov. 30 1987, by T. Warren