


Application No. 59844

Permit No.

45371

T.6N.,R.35E.,W.M.

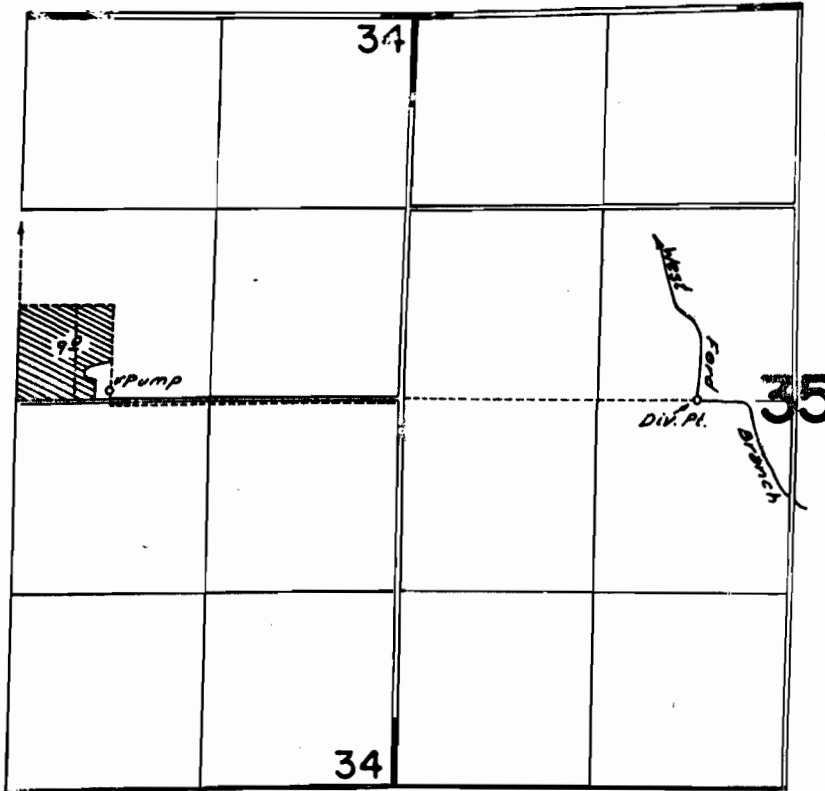

Div. Pt. Loc.: 2000' E. from W. 1/4 Cor. Sec. 35

RECEIVED

NOV 20 1980

WATER RESOURCES DEPT.  
SALEM, OREGON

~~FINAL PROOF SURVEY~~

UNDER

59844

~~Application No. 51840 Permit No. 39035~~

IN NAME OF

Jack D. & Juanita Slusarenko

Surveyed Apr. 7, 1976, by C. R. King

NZ-5MM-69 ACB