



T.6N., R.35E., W.M. Application No. 5845  
 Permit No. 45372

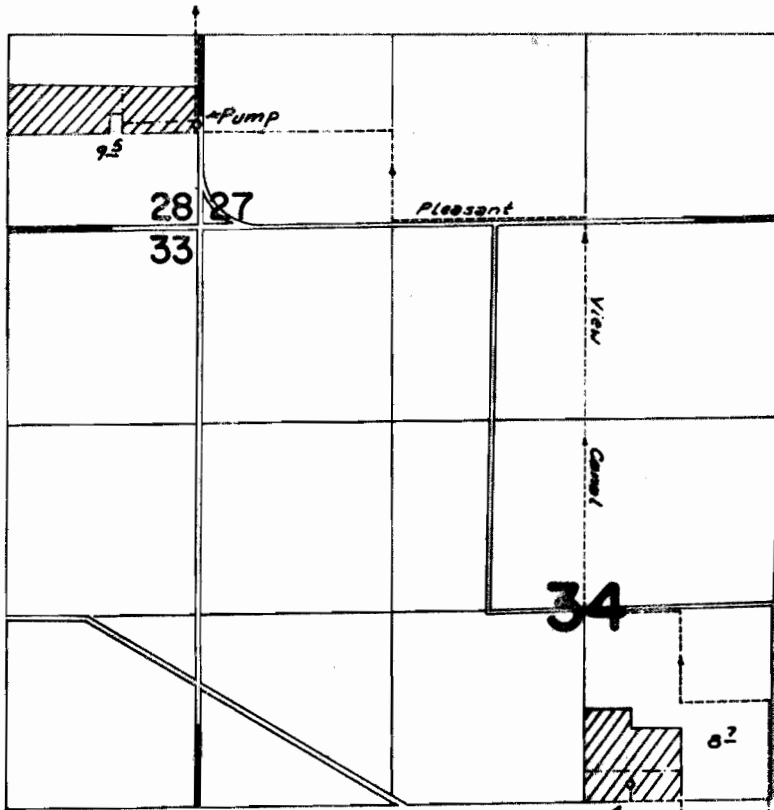

Div. Pt. Loc.: 500' W. from SE. Cor. Sec. 35

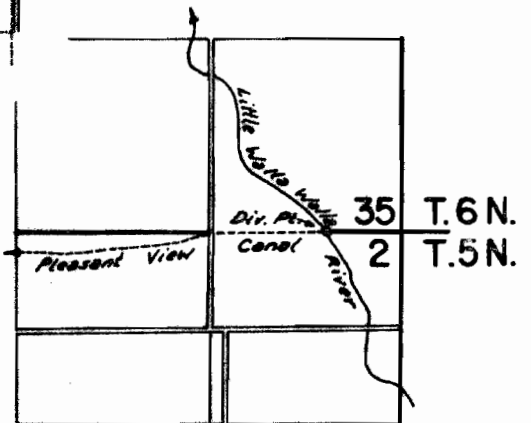

**FINAL PROOF SURVEY**  
 UNDER

**RECEIVED**

NOV 20 1980

WATER RESOURCES DEPT.  
 SALEM, OREGON

Application No. ~~51839~~ Permit No. ~~39094~~  
 IN NAME OF

*Jack D. & Juanita Slusarenko*

Surveyed *Apr. 7 1976*, by *C.R. KING*

NZ-5MM-66 & 69 *LB*