


G10367
6425

T. 6N., R. 35E., W. M.

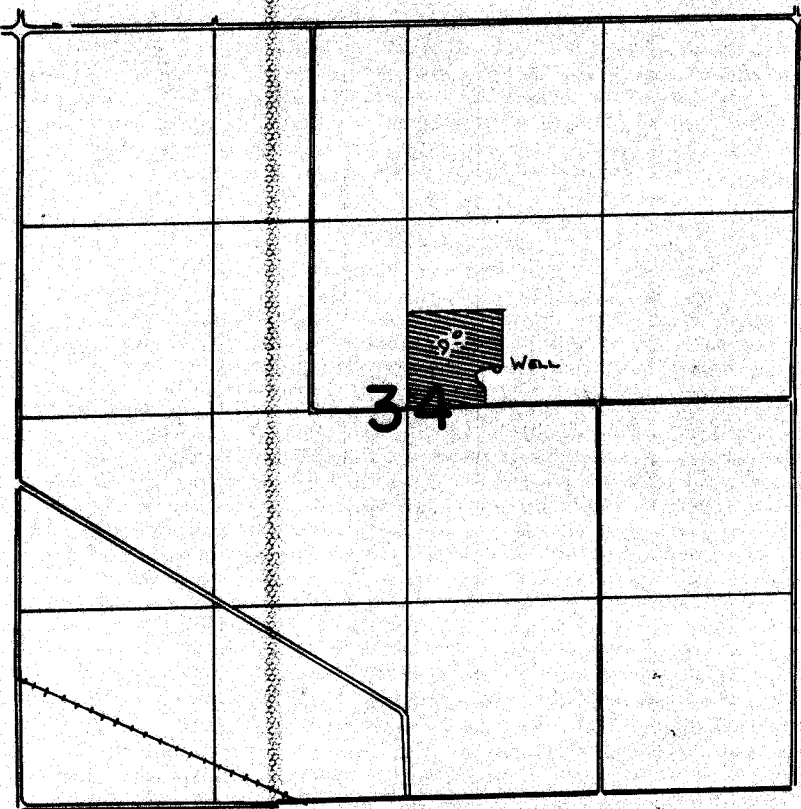

SCALE: 1" = 1320'

WELL LOCATED 250' N. & 610' E. FROM CENTER COR. SEC. 34

FINAL PROOF SURVEY
UNDER

Application No. G:11248 Permit No. G:10367...
IN NAME OF

JACK D. SLUSARENKO

Surveyed 12-24-1984, by V. A. Chvorch...