


T. 39 S., R. 19 E., W.M., LAKE COUNTY

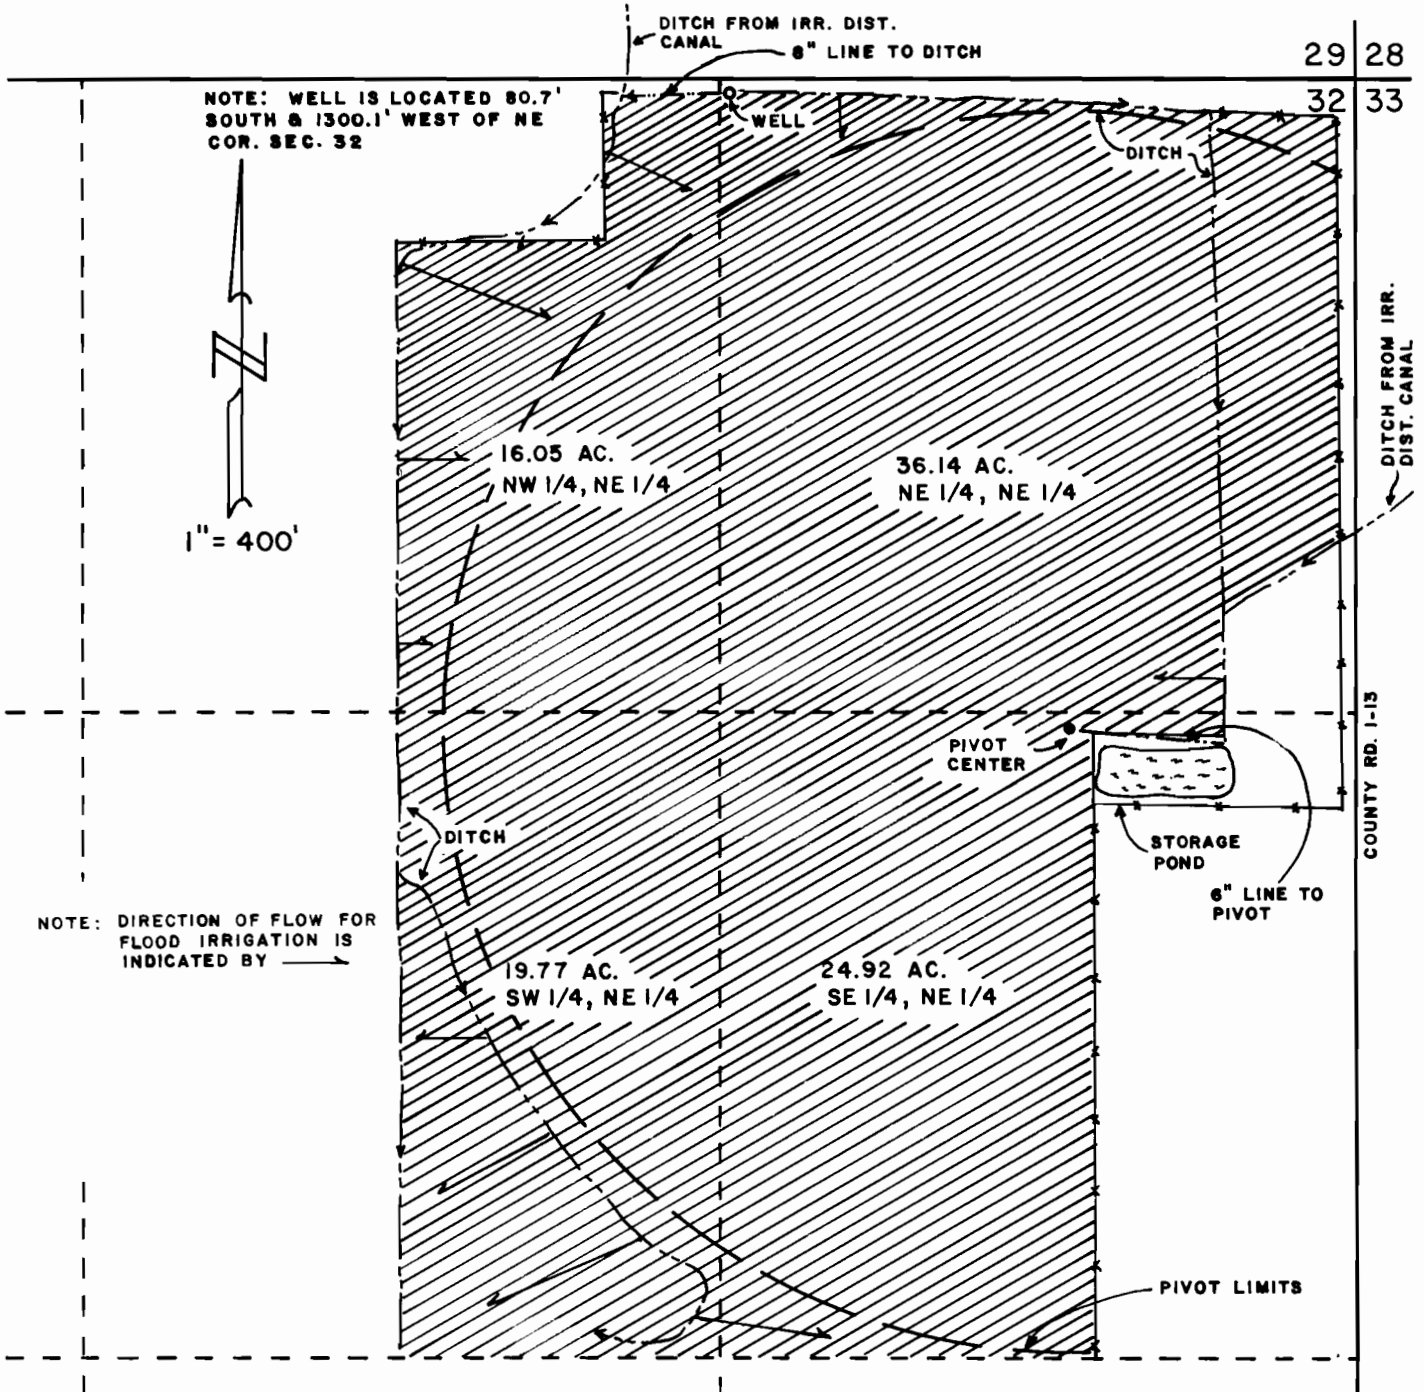

FINAL PROOF SURVEY
UNDER

APPLICATION NO. G-11728

PERMIT NO. G-10842

IN THE NAME OF

JAMES R. STEWART

SURVEYED BY: ANDERSON ENGINEERING & SURVEYING
APRIL 21, 1989

