


T.8S. R.5 & 6W. W.M.

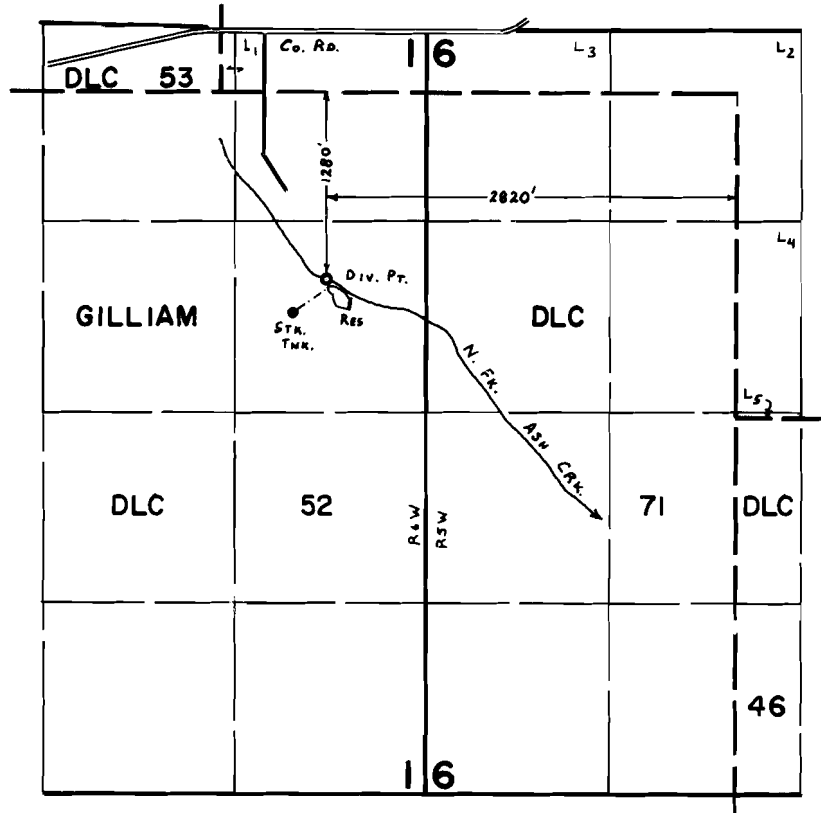

FINAL PROOF SURVEY UNDER

R-49428 R-6176
 Application No. ~~49429~~ Permit No. ~~38233~~.....
 IN NAME OF

EARL L. WORTHINGTON

Surveyed July 17, 1979, by C. L. HUGHES