


# T.8S. R.5 & 6W. W.M.

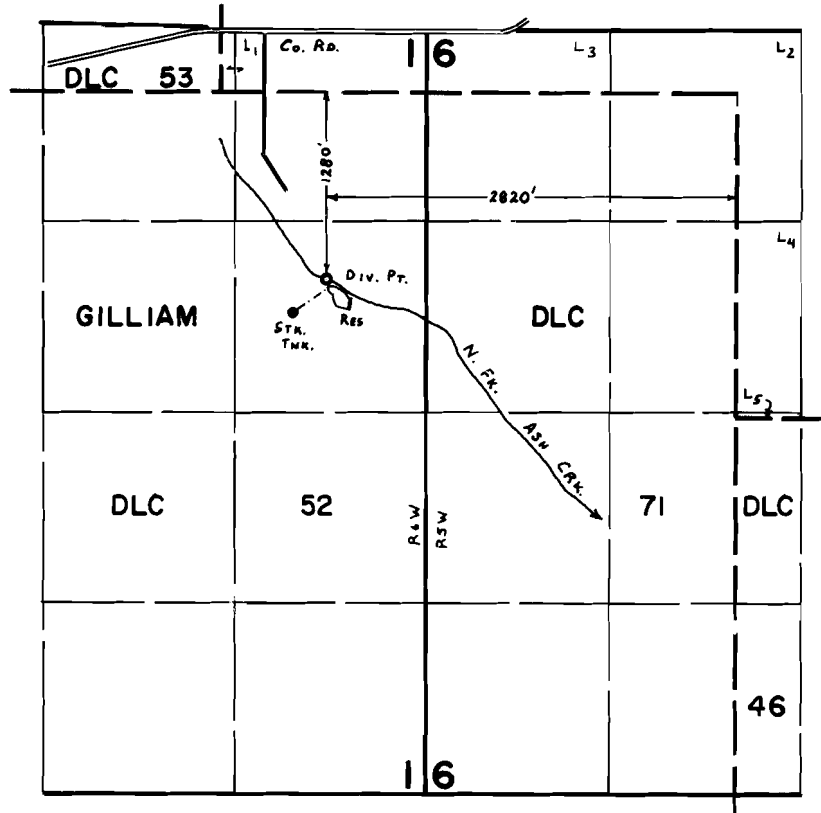

## FINAL PROOF SURVEY UNDER

R-49428                      R-6176  
 Application No. ~~49429~~ Permit No. ~~38233~~.....  
 IN NAME OF

**EARL L. WORTHINGTON**

Surveyed July 17, 1979, by C. L. HUGHES