


TOWNSHIPS 10&11 SOUTH, RANGE 25&26 EAST, W.M.

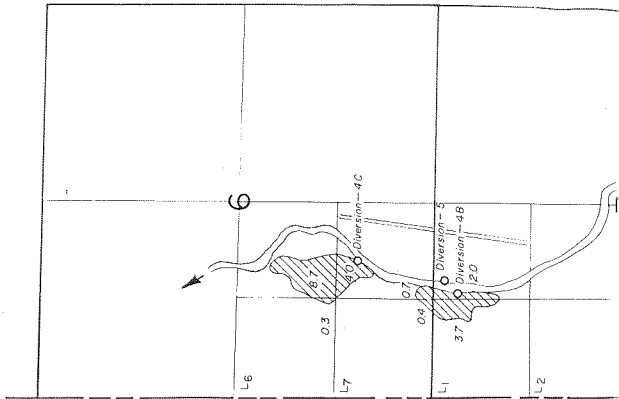

DIVERSION POINTS LOCATED:
 No. 1 - 430' S. & 390' E. from W. 1/4 Cor. Sec. 30
 No. 2 - 2550' S. & 220' E. from W. 1/4 Cor. Sec. 30
 No. 3 - 1670' S. & 1140' E. from NW Cor. Sec. 31
 No. 4 - 580' N. & 1690' E. from SW Cor. Sec. 7
 No. 4B - 330' S. & 1430' E. from SW Cor. Sec. 7
 No. 4C - 1030' N. & 1870' E. from NW Cor. Sec. 7
 No. 5 - 150' S. & 1600' E. from NW Cor. Sec. 19
 No. 6B - 3620' N. & 1340' E. from SW Cor. Sec. 19
 ABOVE WITHIN T. 10S., R. 26E., W.M.
 No. 7 - 520' S. & 660' E. from NW Cor. Sec. 6
 WITHIN T. 11S., R. 26E., W.M.

 PERMIT 37994
 PERMIT 43772

