


T.2N., R.10E., W.M.

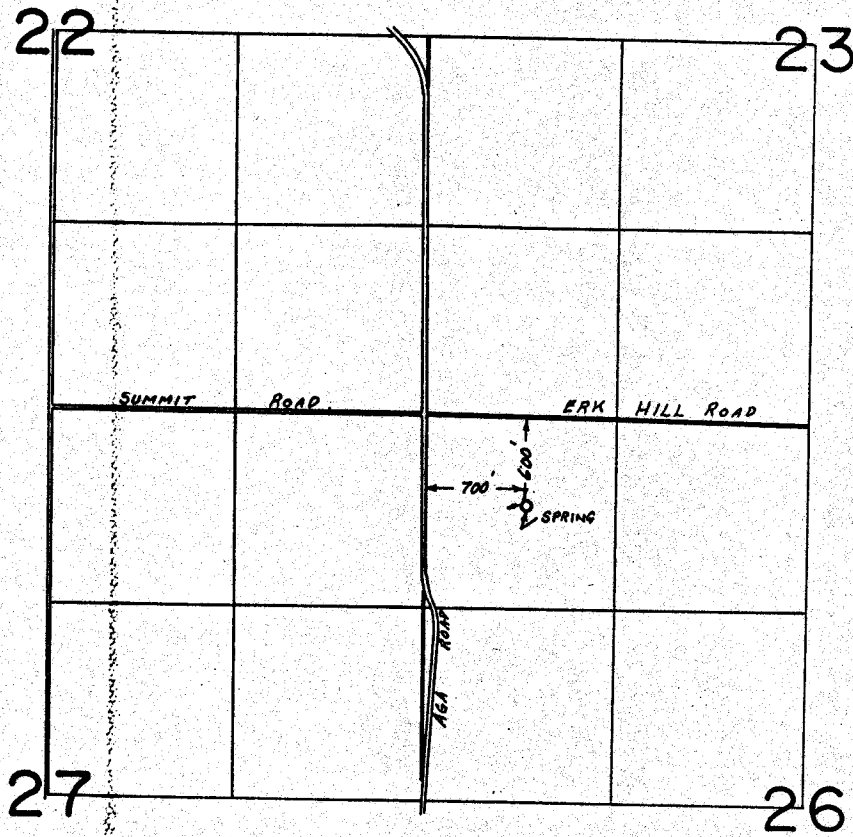

FINAL PROOF SURVEY
UNDER

Application No. 52089.. Permit No. 39247.....
IN NAME OF

.....
LOIS E. VANCE
.....

Surveyed APR. 16... 19.80, by R. G. MUCKEN.....

PHOTO. 27-87 SE

SWB