


T19S. R2W. WM.

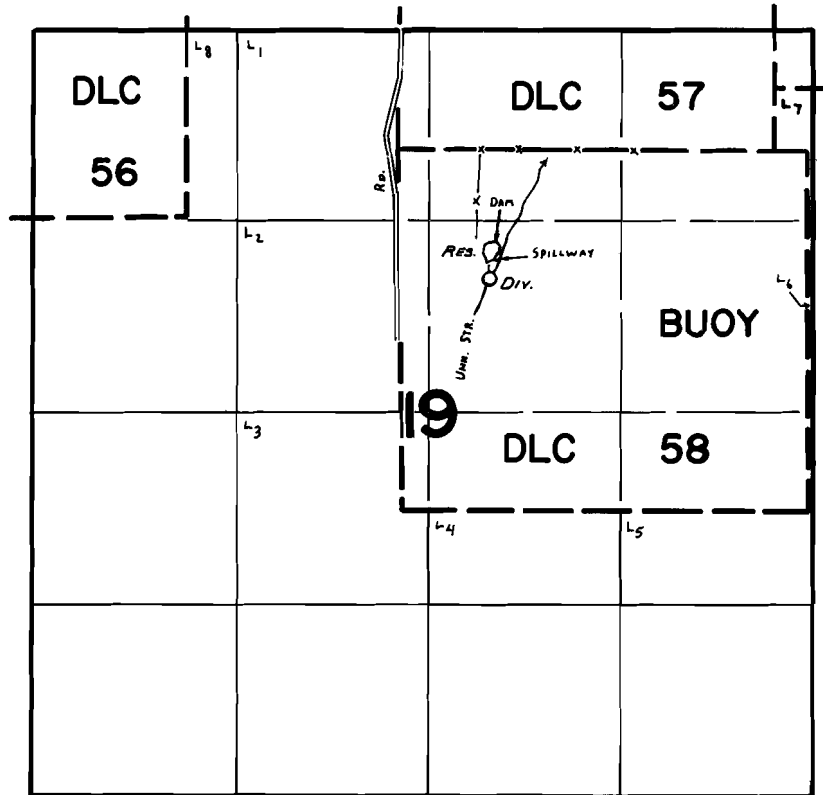

DAM Loc: 630' S. & 680' E. fr. N.W. Cor. Buoy DLC 58.
STREAM Div: 880 ft. S. and 630 ft. E. from the NW Cor. Buoy DLC 58

FINAL PROOF SURVEY
UNDER

52651 39458
Application No. R-52373 Permit No. R-6319
IN NAME OF

W. G. NASH

Surveyed JULY 20, 1978, by C. L. HUGHES
Aug. 19, 1981 S. C. BROWN