


T. 5 S., R. 5 W. WM.

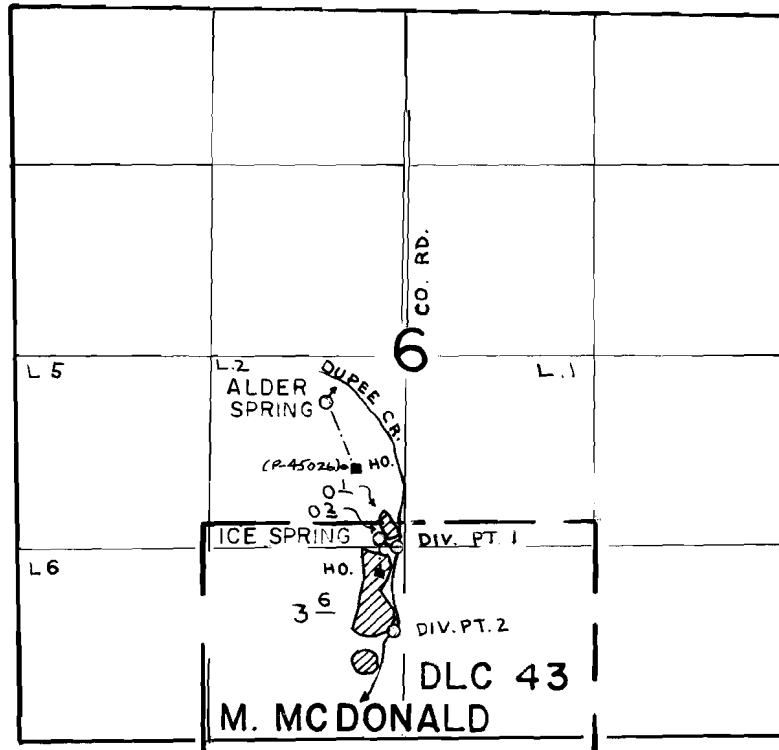

SCALE
1" = 1320'

DIV. PTS. (1) 1320' S. & 50' W.
(2) 1900' S. & 70' W.
ICE SPRING 1260' S. & 150' W.
ALDER SPRING 330' S. & 550'
ALL FROM THE CENTER SEC 6

FINAL PROOF SURVEY UNDER

Application No. 53279 39537
60025 Permit No. 45026
IN NAME OF

PETER F. ROSE

Surveyed OCT. 1, 1984, by R. PASTER