


T. 37S., R. 7 W., W.M.

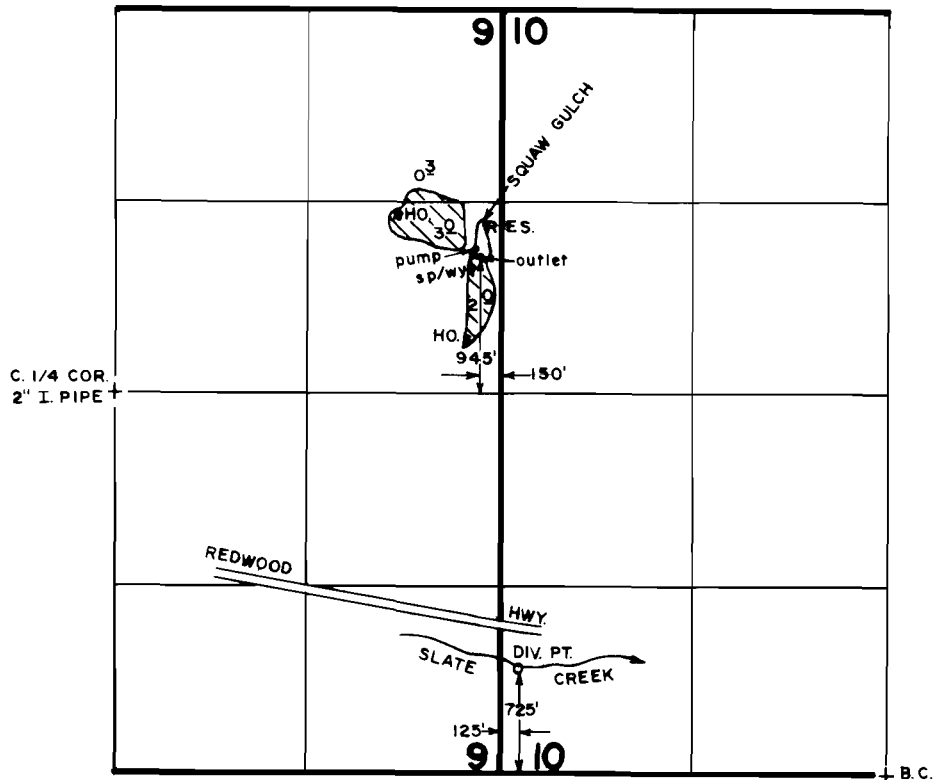

**FINAL PROOF SURVEY**  
UNDER

R-53363                      R-6340

Application No. 53364 Permit No. 39590...  
IN NAME OF

**JAMES W. & DAVID A. BASSETT**.....

Surveyed OCT. 25 1983, by B. S. JAMES.....