T. 37S., R. 7 W., W.M.

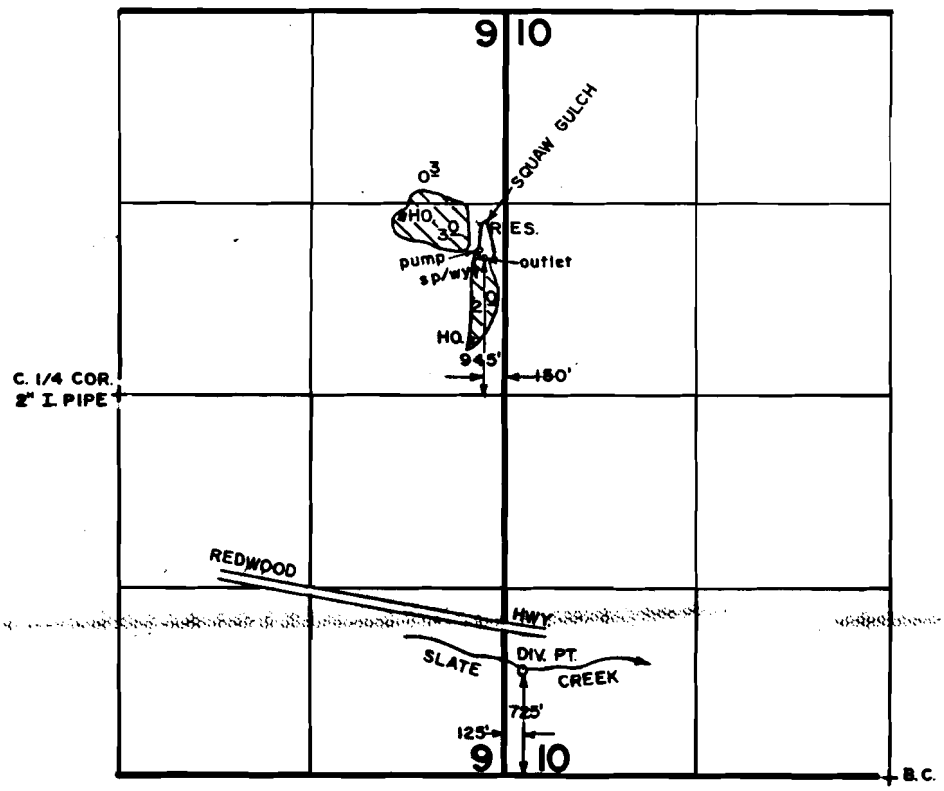

FINAL PROOF SURVEY

UNDER

R-53363 R-6340

Application No. 53364 Permit No. 39590

IN NAME OF

JAMES W. & DAVID A. BASSETT

Surveyed OCT. 25 19 83, by B. S. JAMES

179-170L TWB