


T6S. R6W. WM.

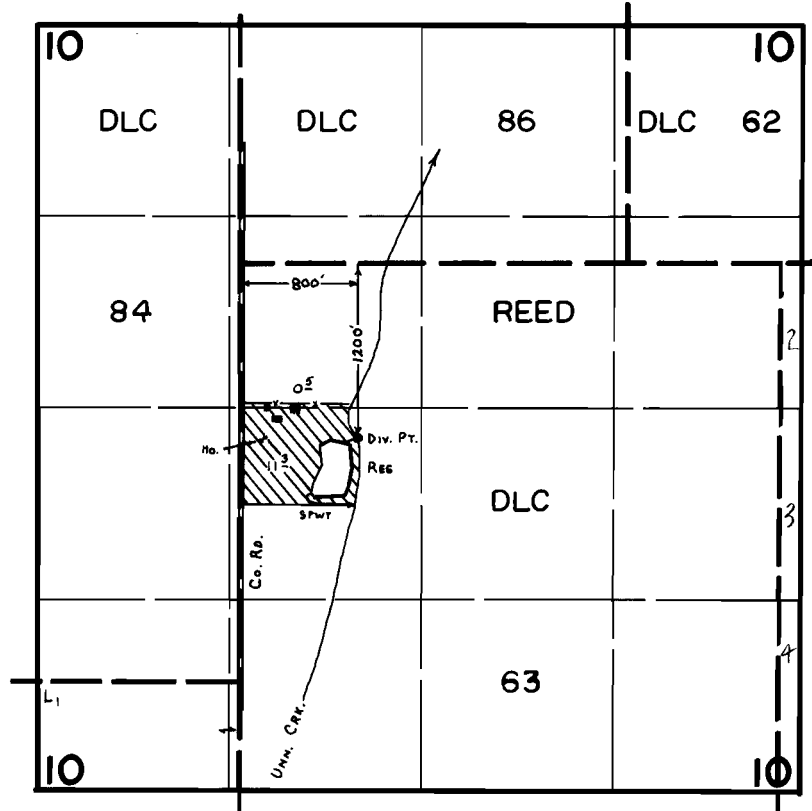

FINAL PROOF SURVEY UNDER

R-53470 R-6372
 Application No. 53471 Permit No. 39619.....
 IN NAME OF

.....**WALTER H. WEGENER**.....

Surveyed June 5, 1979, by C. L. HUGHES...