


T.11&12S. R.2W.W.M.

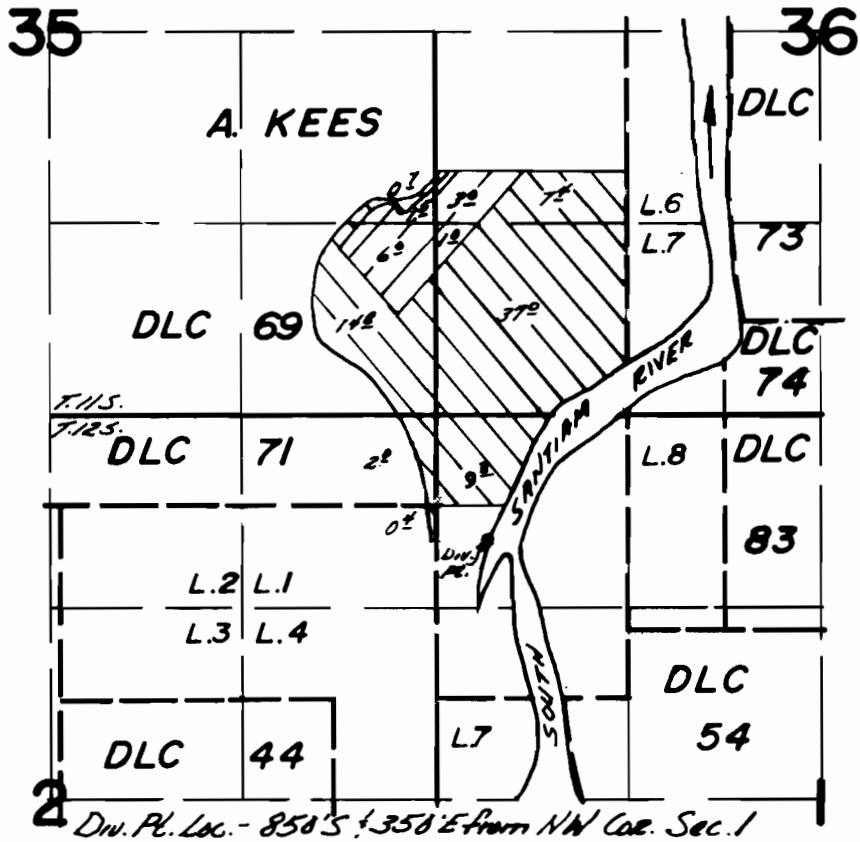

54273 →  → Primary  → Suppl.

56101 → All land mapped above is Supplemental

FINAL PROOF SURVEY UNDER

Application No. 54273. Permit No. 42237
40643....
IN NAME OF

.....WALTER.....JACK.....SCOTT.....

Surveyed April..25. 1979., by S.C.BROWN.....