T.11&12S. R.2W.W.M.

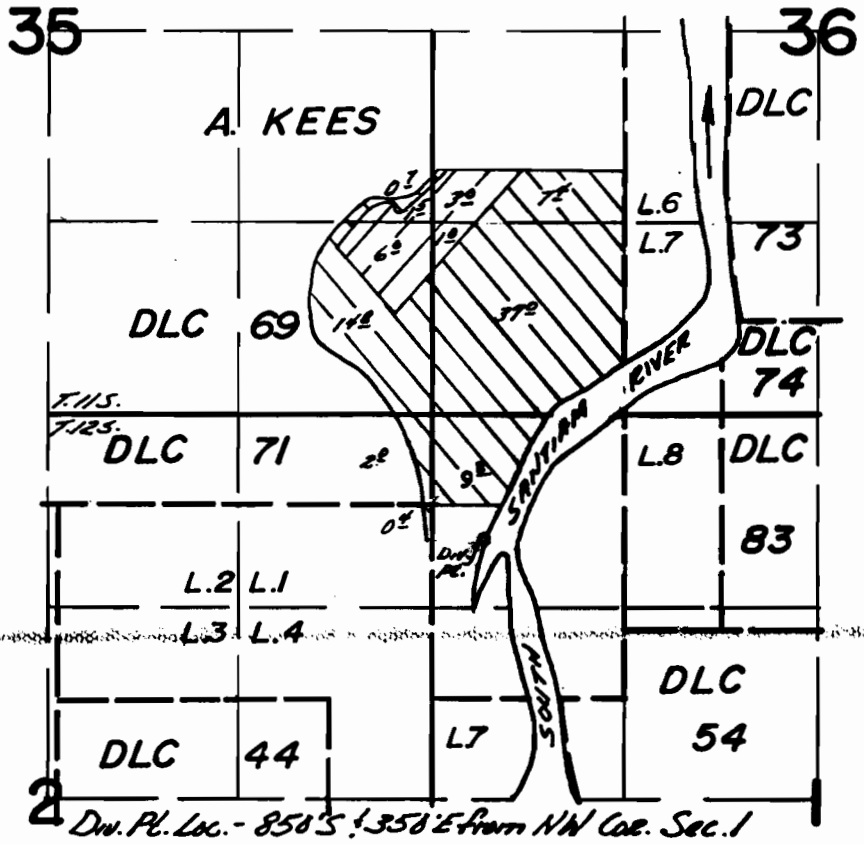

54273 → Permary → Suppl.

56101 → All land mapped above is Supplemental

FINAL PROOF SURVEY

UNDER

Application No. 56101 54273. Permit No. 42237 40643....

IN NAME OF

WALTER JACK SCOTT

Surveyed April 25 1979., by S.C. BROWN.....

DFM-3LL-23 RR.