


T. 4 S. R. 3 W. W.M.

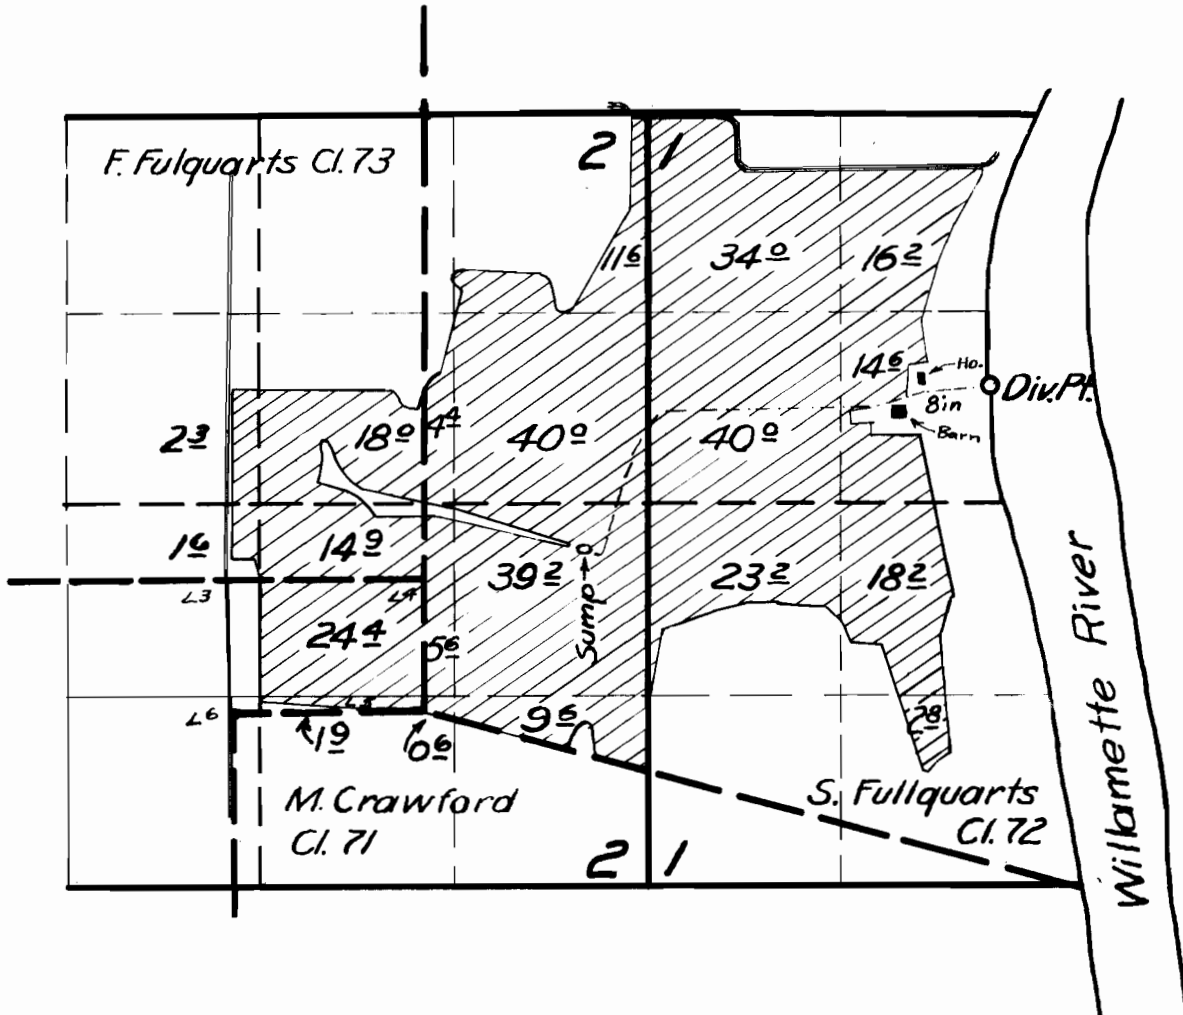

FINAL PROOF SURVEY

UNDER

Application No. 28048 Permit No. 22063

IN NAME OF

David Saucy

Surveyed Mar. 6 1956, by M. Bush