
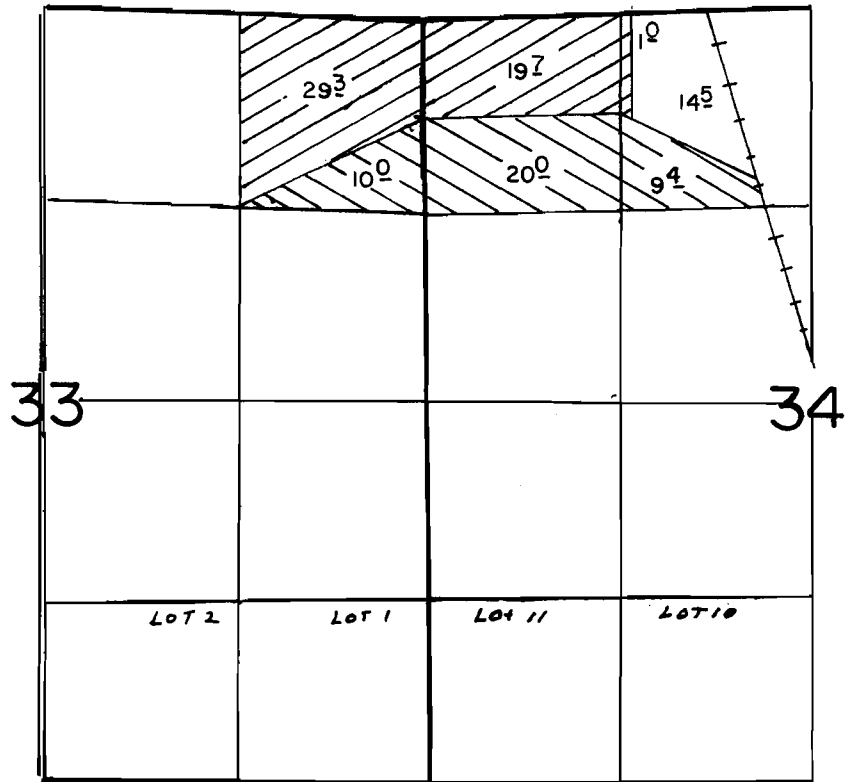


44278
64647

T. 39 S., R. 20 E., W. M.

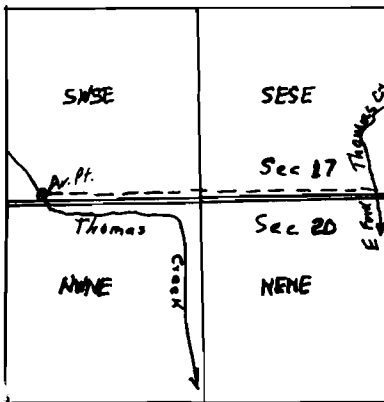

N

Div Pt Loc 250' E & 30' N From The N 1/4 Corner Of Section 20

SCALE: 1" = 1320'

FINAL PROOF SURVEY UNDER

Application No. 58167... Permit No. 44278.....
IN NAME OF

..DON.E.&.NORMA..ALLEN..BLYTHE..

Surveyed OCT. 19.. 1987., by V.L. CHURCH.....