


T.16S., R.88&9W., W.M.

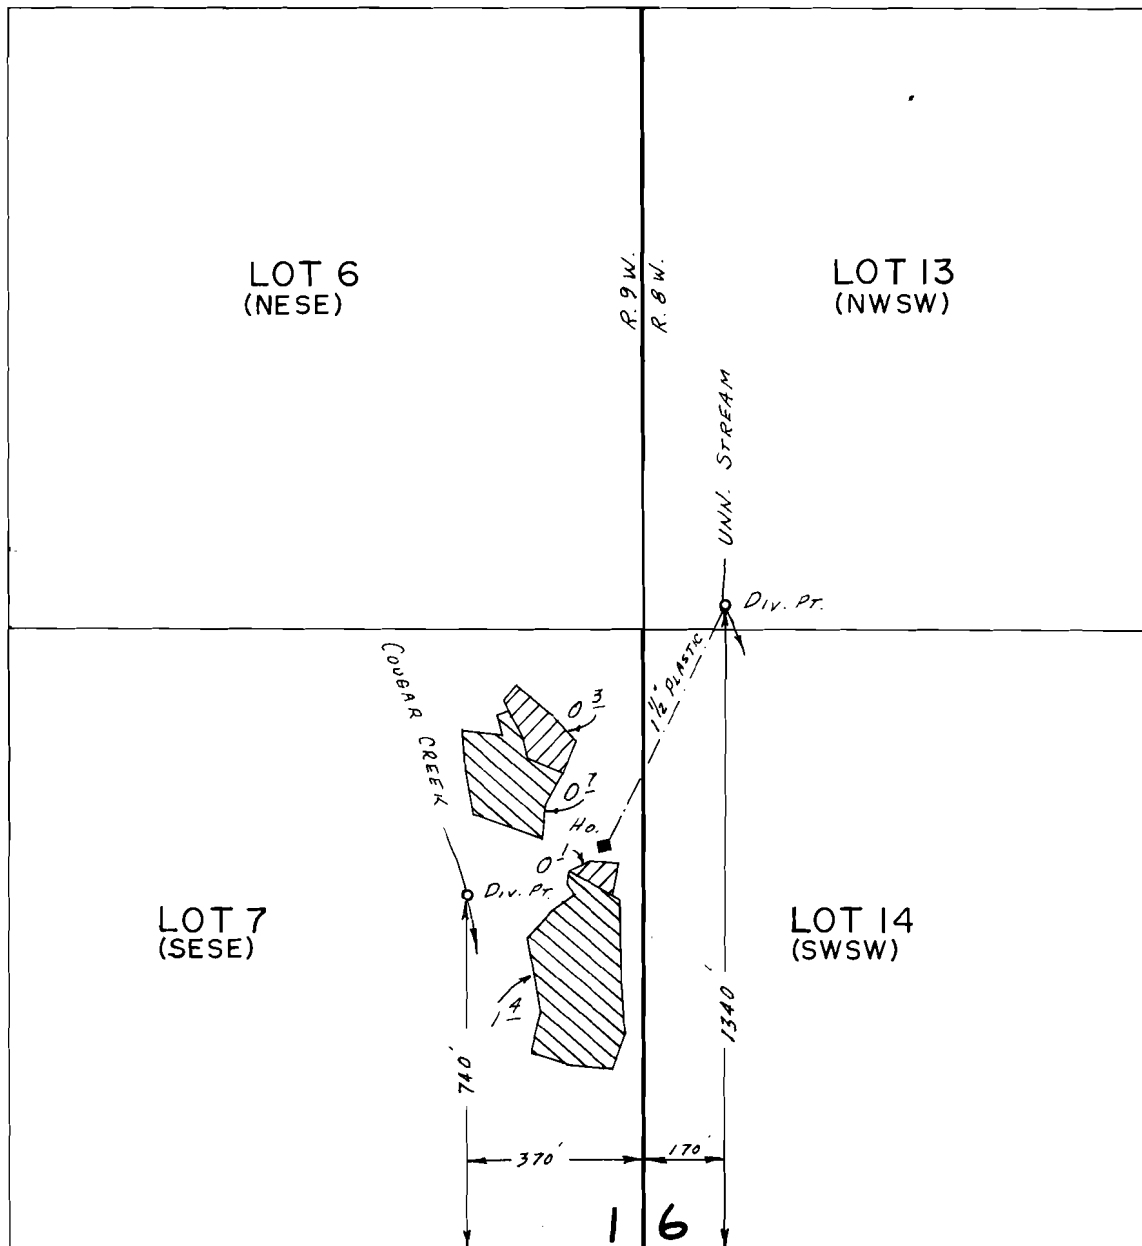

UNNAMED STREAM

COUGAR CREEK

SCALE: 1" = 400'

FINAL PROOF SURVEY

UNDER

Application No. 58741... Permit No. 44998.....
IN NAME OF

.....SCOTT H. BONCI.....

Surveyed JULY 30, 1986, by ..B.W..BISHOP.....

12/31/86
BWB

PTS 1986 B