


T. 36 S., R. 4 W., W.M.

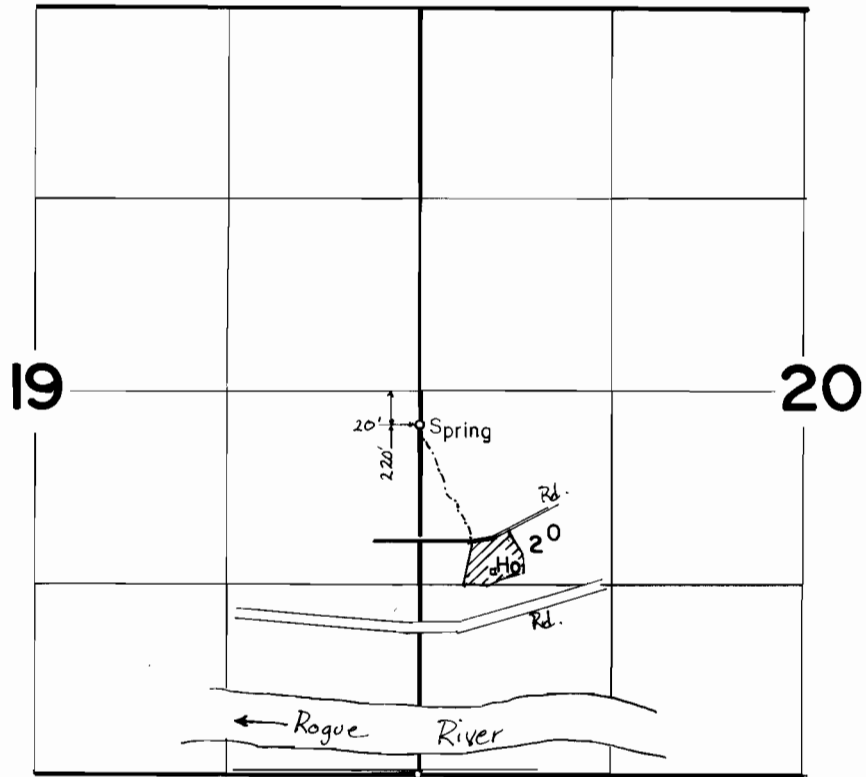

FINAL PROOF SURVEY
UNDER

Application No. 58904 Permit No. 44360.....
IN NAME OF

LEROY S. &/OR MARY T. LOWMAN

Surveyed APRIL 22, 1983, by B. S. JAMES.....