


T. 19 & 20 S., R. 47 E., W.M.

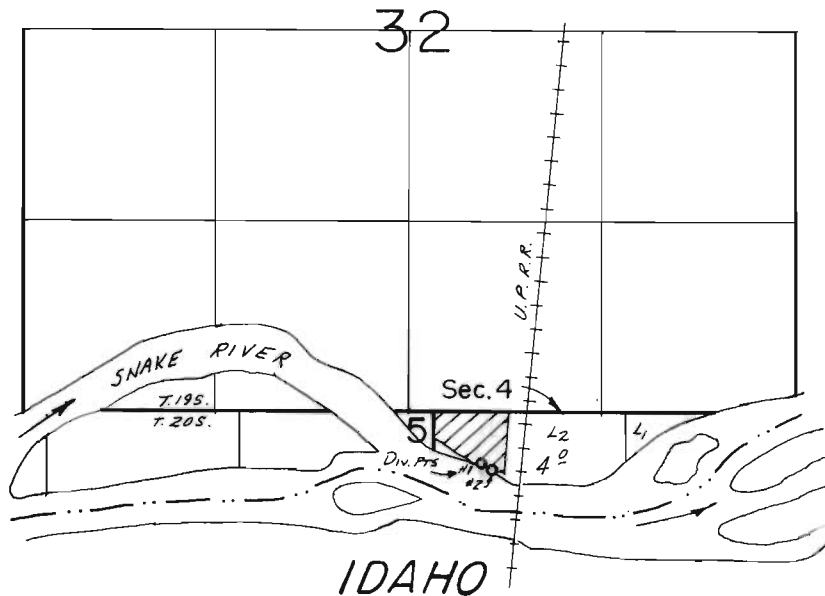

DIV. PTS. LOC.: #1-350'S. § 500'E., #2-400'S. § 570'E., BOTH FROM S 1/4 COR. SEC. 32.

SCALE: 1" = 1320'

FINAL PROOF SURVEY
UNDER

Application No. 58933... Permit No. 44423.....
IN NAME OF

..... OTIS HORN

Surveyed Mar. 26.. 19.86., by L. M. TOLL.....