


T. 1 S., R. 3 W., W. M.

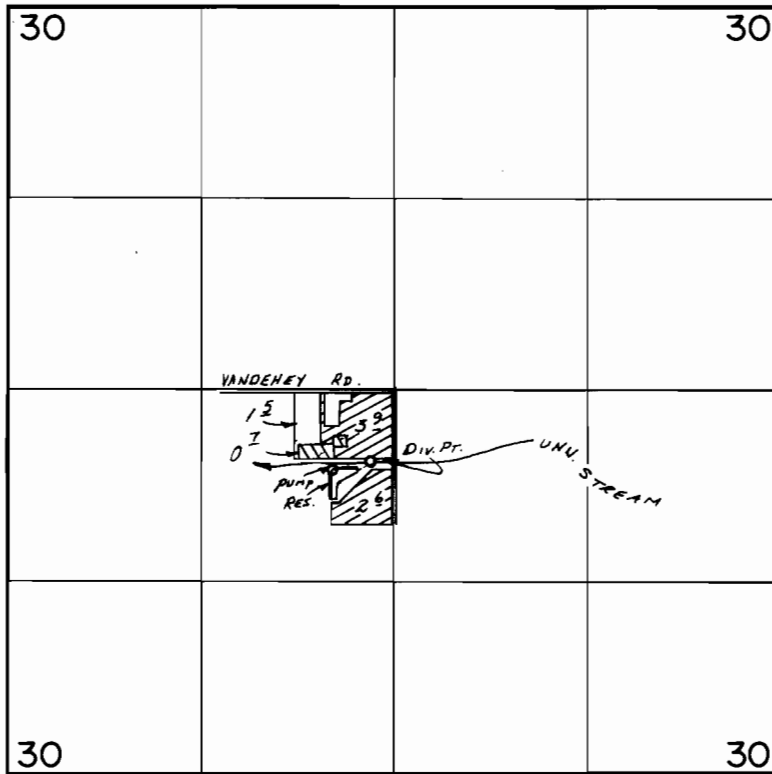

DIV. PT. LOC. 490' S. & 160' W. FROM C 1/4 SEC. 30.
 Res. LOC. 520' S. & 420' W. from the C 1/4 Cor. Section 30

SCALE: 1" = 1320'

 PRIMARY

 SUPPLEMENTAL

FINAL PROOF SURVEY UNDER

R-59207 R-8113
 Application No. 59208.. Permit No. 44799.....
 IN NAME OF

.....IVAN & PATRICIA HEIN.....

Surveyed Aug. 14... 19.86, by B.W. BISHOP.....

1/9/87
 BWS
 41067-178-109D