


# T. 5 S., R. 2 E., W.M.

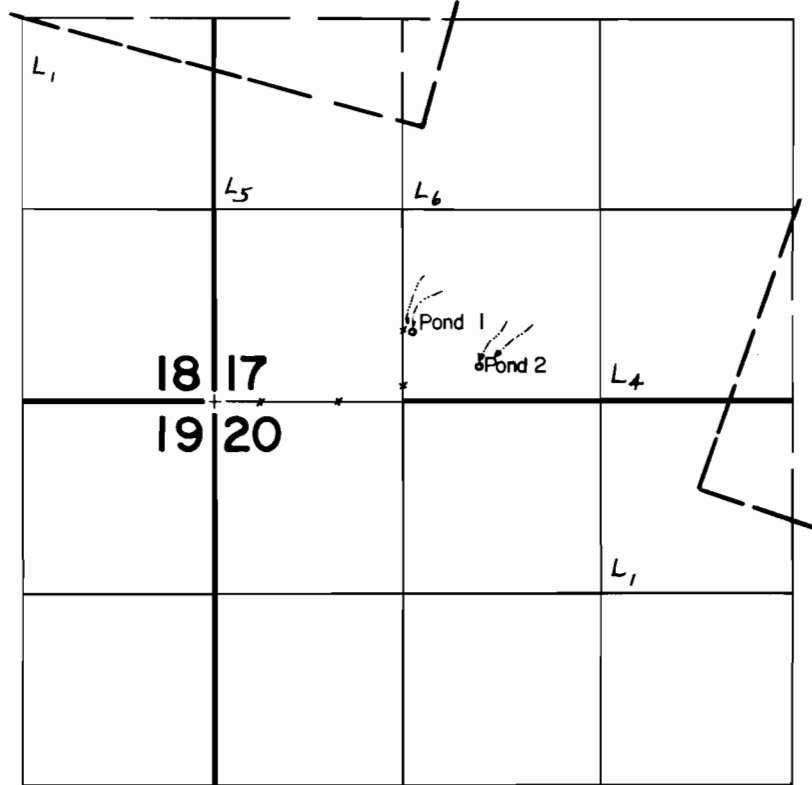

Pond 1 Loc.: 480' N. & 1350' E.  
 Pond 2 Loc.: 230' N. & 1800' E. both from SW Cor. Sec. 17.

Scale: 1" = 1320'

## FINAL PROOF SURVEY UNDER

Application No. R-59288 Permit No. R-8154  
 IN NAME OF

**ELTON L. LANTZ**

Surveyed JUNE 23, 1986., by T. Warren