


T.17&18S., R.46&47E., W.M.

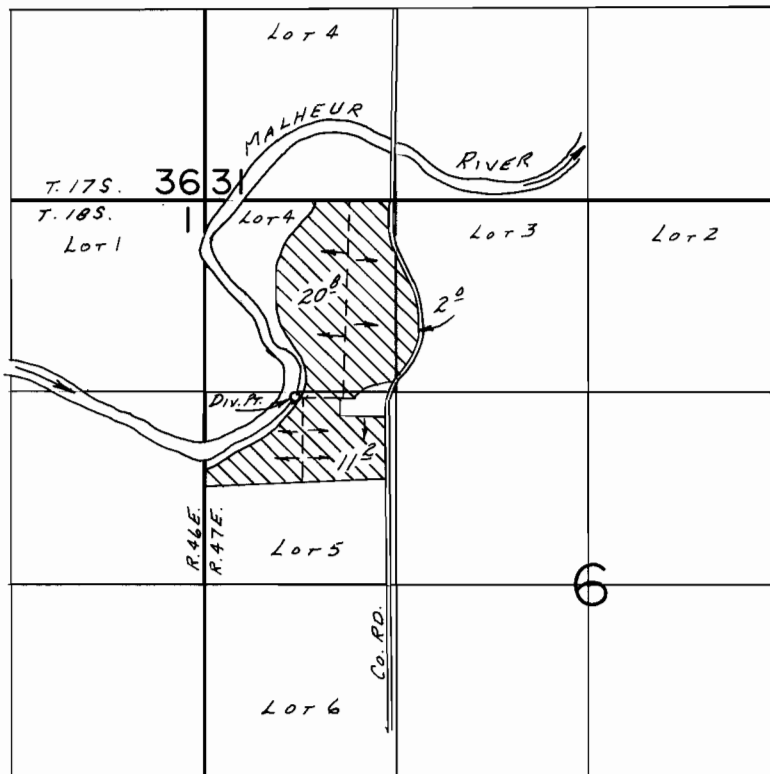

Div. Pt. LOC.: 1350'S. & 620'E. FROM NW COR. SEC. 6.

SCALE: 1"=1320'

FINAL PROOF SURVEY UNDER

Application No. 59295... Permit No. 44905.....
IN NAME OF

.....JAMES F. MATHEWS.....

Surveyed Mar. 6..... 19.86, by L.M.TOLL.....