


T. 36 S., R. 7 W., W. M.

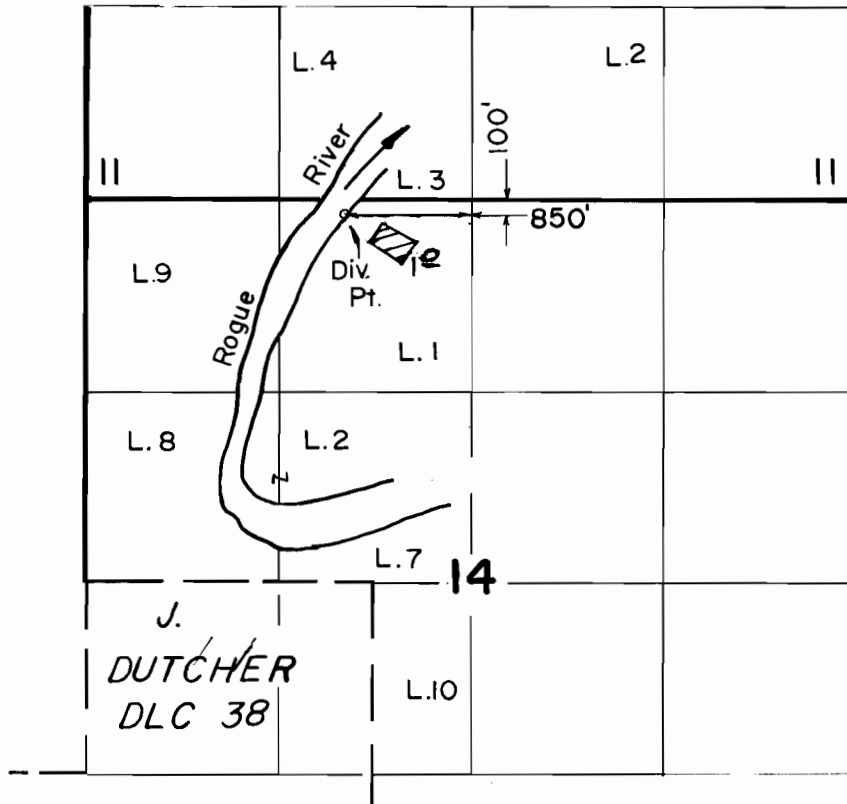

Scale: 1" = 1320'

FINAL PROOF SURVEY
UNDER

Application No. **59335** Permit No. **44630**
IN NAME OF

.....
Surveyed **OCT. 6** 19**87**, by **B. S. JAMES**.....