


T. 37S, R14 & 15W, WM.

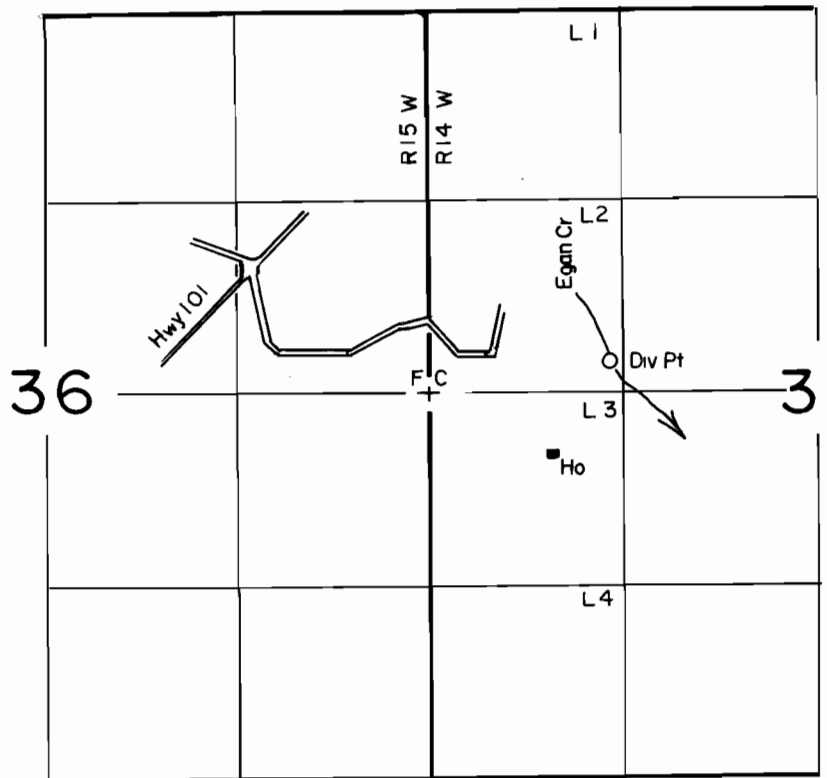

Div Pt Loc 210' N & 1230' E' From The W1/4 Corner Of Section 31

SCALE: 1" = 1320'

FINAL PROOF SURVEY UNDER

Application No. 59.352... Permit No. 44632.....
IN NAME OF

.....**GEORGE H & MARGIE WESTFALL**.....

Surveyed JULY 28... 1989... by B.S. JAMES.....