


T. 7N., R. 5W., W.M.

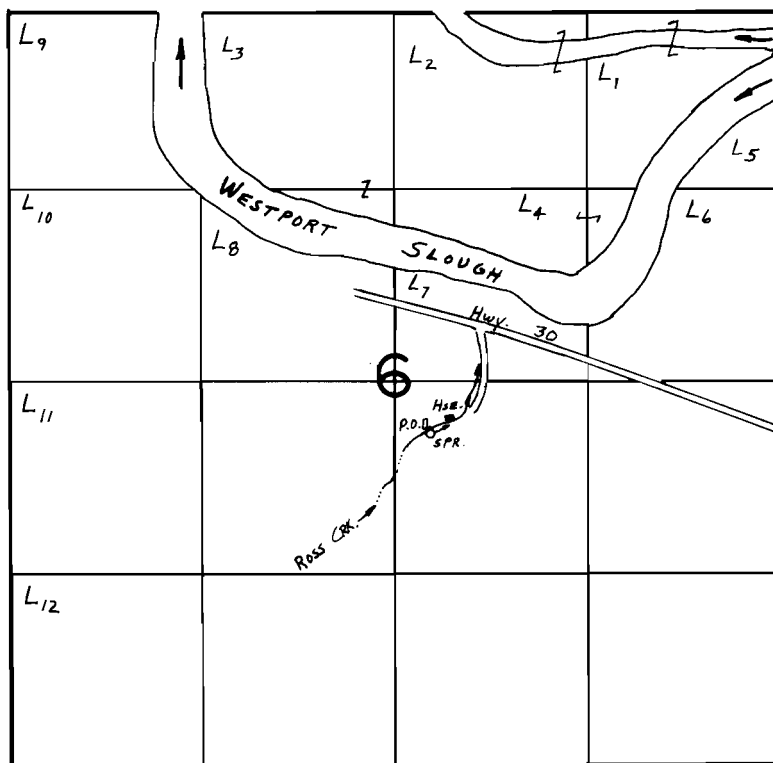

P.O.D. Loc.: 360' S. & 240' E. from C. 1/4 Cor. Sec. 6.

Scale: 1" = 1320'

FINAL PROOF SURVEY UNDER

Application No. 59386.. Permit No. 45630.....

IN NAME OF

WILLIAM D. & MARIE OLSTEDT

Surveyed AUG. 11... 1986., by T. Warren.....