


T. 9S., R. 10W., W.M.

Sec. 33

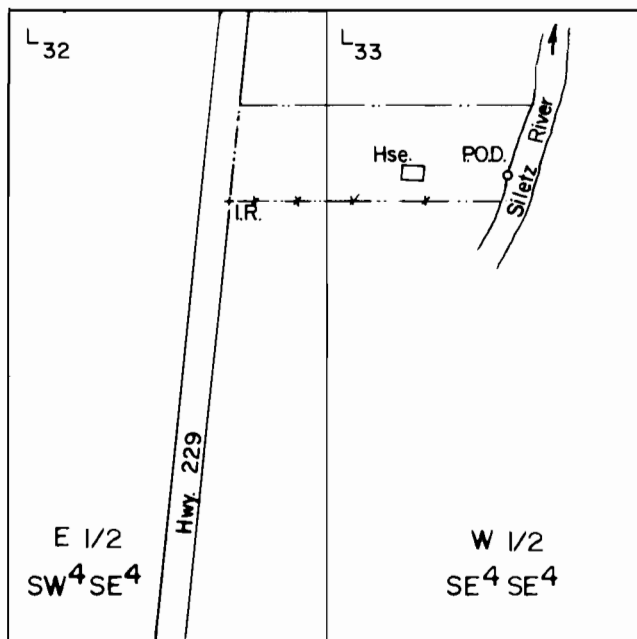

P.O.D. Loc.: 345' S. & 375' E. from NW Cor. SE 4 SE 4, Sec. 33.

Scale: 1" = 400'

FINAL PROOF SURVEY UNDER

Application No. 59460... Permit No. 44856.....
IN NAME OF

BEN J. DOTY

Surveyed AUG. 5, 1986., by T. Warren