


T. 5S., R. 3W., W.M.

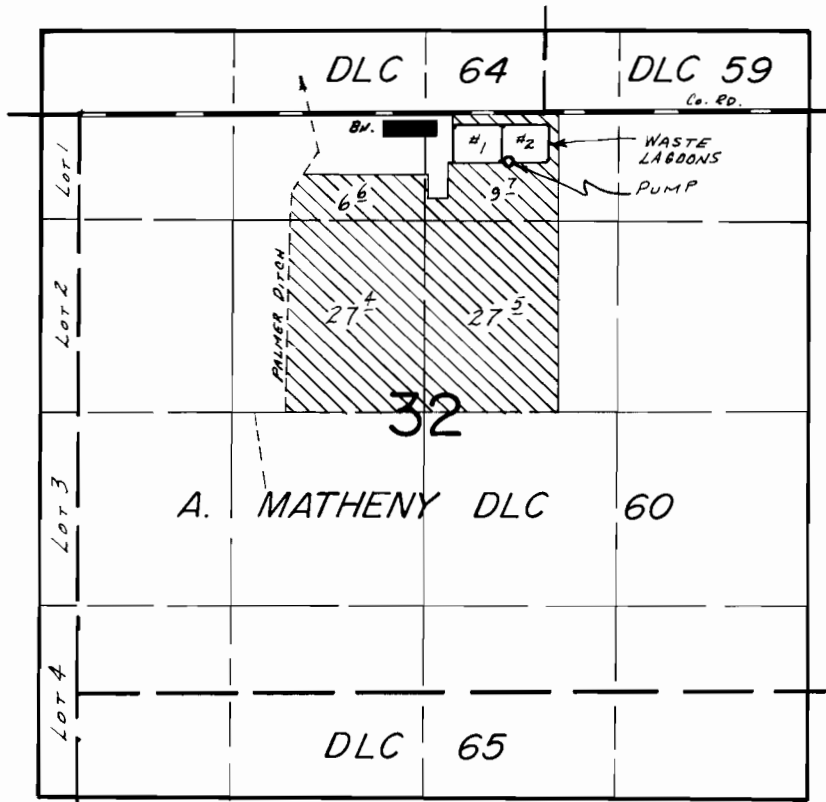

Div. Pt. Loc.: 340 S. & 2950 E FROM NW COR. A. MATHENY DLC 60.

SCALE: 1" = 1320'

FINAL PROOF SURVEY UNDER

R-59721 R-8180
Application No. 59722.. Permit No. 45189.....
IN NAME OF

.....PETE DEHAAN.....

Surveyed Sept. 5.... 19.85, by B.W. BISHOP.....