


T. 5S., R. 3W., W.M.

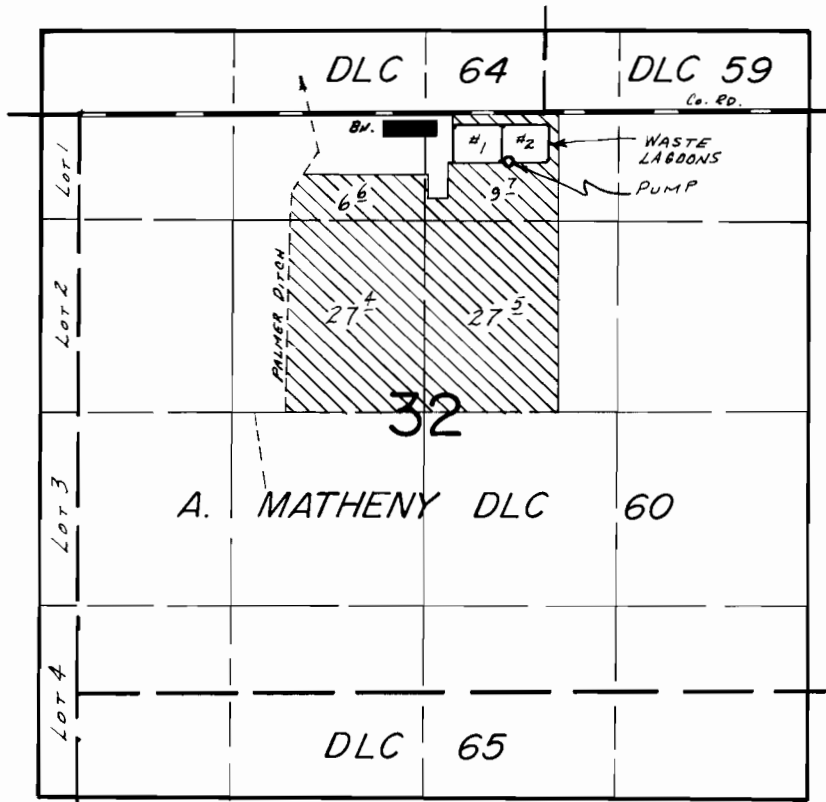

*Div. Pt. Loc.: 340 S. & 2950 E FROM NW COR. A. MATHENY DLC 60.*

SCALE: 1" = 1320'

**FINAL PROOF SURVEY**  
UNDER

R-59721                      R-8180  
Application No. 59722.. Permit No. 45189.....  
IN NAME OF

.....PETE DEHAAN.....

Surveyed Sept. 5.... 19.85, by B.W. BISHOP.....