


# T.6S., R.10W., W.M.

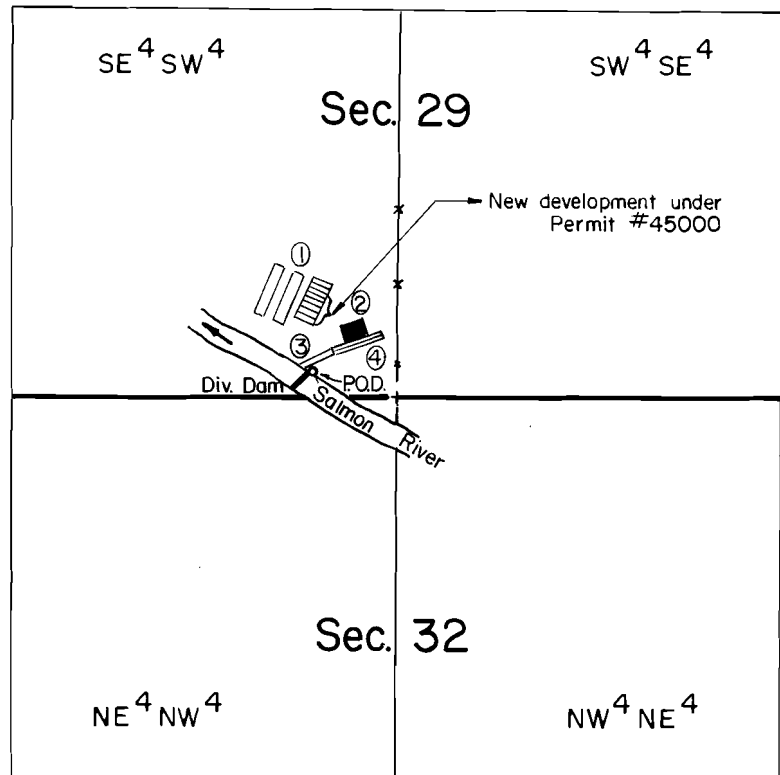

- 1- Rearing Ponds
- 2- Incubation Room
- 3- Fish Ladder
- 4- Adult Holding Ponds

P.O.D. Loc. : 75' N. & 290' W. from S. 1/4 Cor. Sec. 29.

Scale : 1" = 660'

## FINAL PROOF SURVEY UNDER

Application No. 59752 Permit No. 45000.....  
IN NAME OF

OREGON DEPARTMENT OF FISH AND WILDLIFE

Surveyed JUNE 16, 1986, by T. Warren.....

CHAIN SURVEY  
3/19/87 TMW