


T. 35 S.

R. 3 W., W.M.

R. 2 W., W.M.

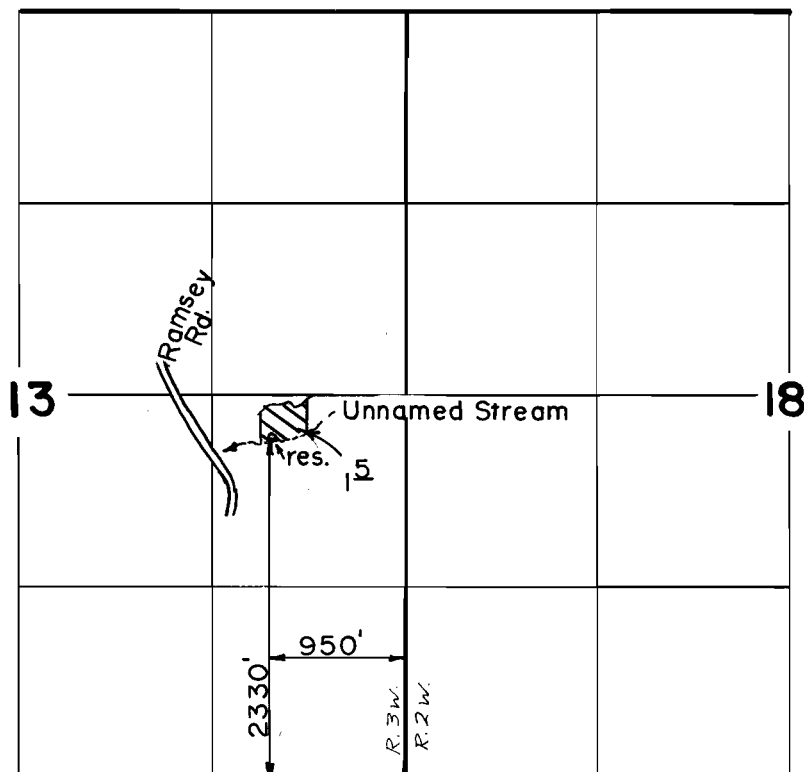

Scale: 1" = 1320'

FINAL PROOF SURVEY

UNDER

R-59821

R-8162

Application No. 59822 Permit No. 44986
IN NAME OF

EUGENE D. & BARBARA J. COUCH

Surveyed JUN. 9 1987, by B. S. JAMES