


T.2S., R.2W., W.M.

SEC. 26

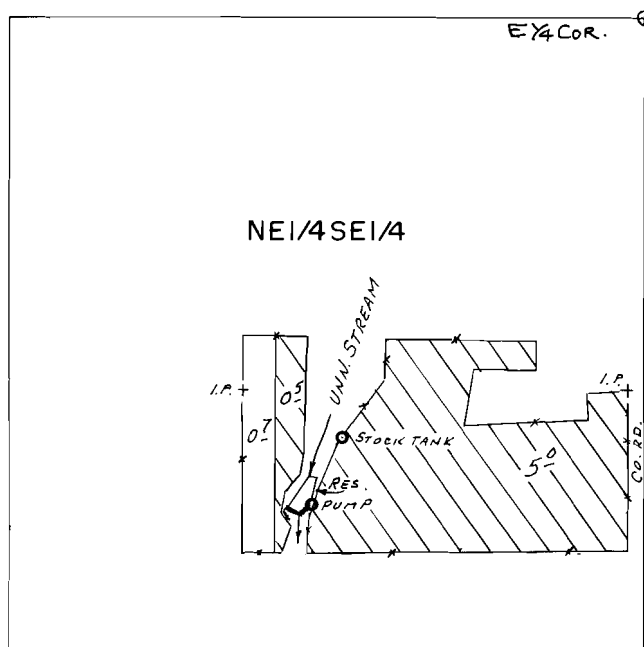

Div. Pt. Loc.: 1030 S. & 720 W. FROM E 1/4 COR. SEC. 26

SCALE: 1" = 400'

FINAL PROOF SURVEY UNDER

R-59832 R-8196
Application No. 59833.. Permit No. 45284.....
IN NAME OF

CHARLES G. & LU ANN DeRIDDER

Surveyed Aug. 28.. 1986., by B.W. BISHOP.....

1-28-87

BWB

PTS 1986 B