


T. 30S., R. 5 W., W.M.

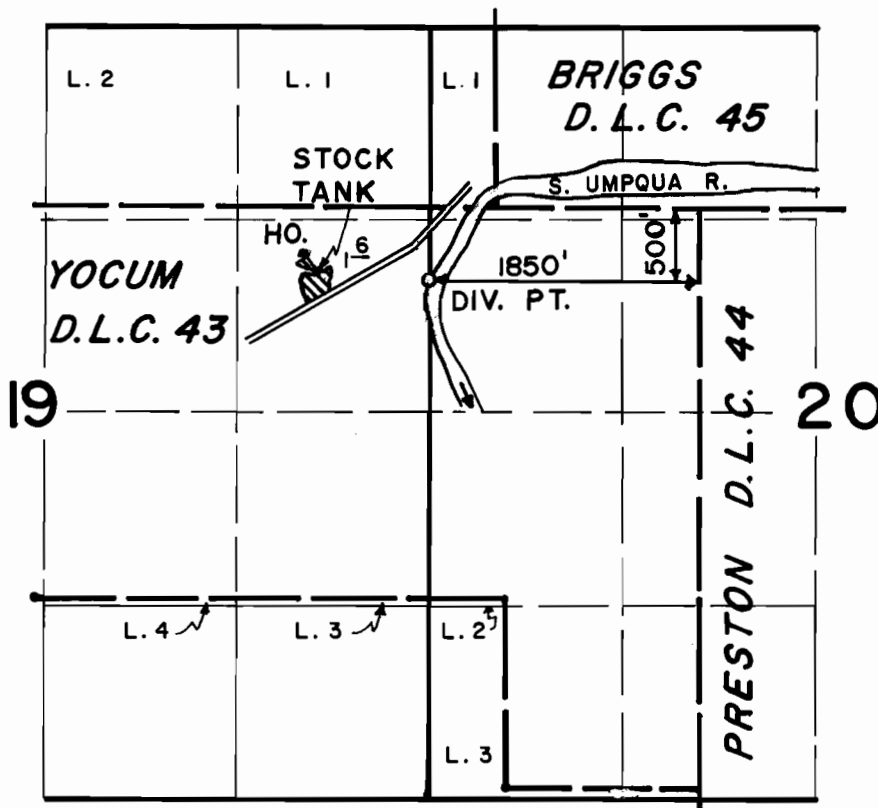

SCALE: 4" = 1 mile

FINAL PROOF SURVEY UNDER

Application No. 59835 Permit No. 44993
IN NAME OF

DALE E CARPENTER

Surveyed JUNE 11, 1984, by D.K. CLARK