


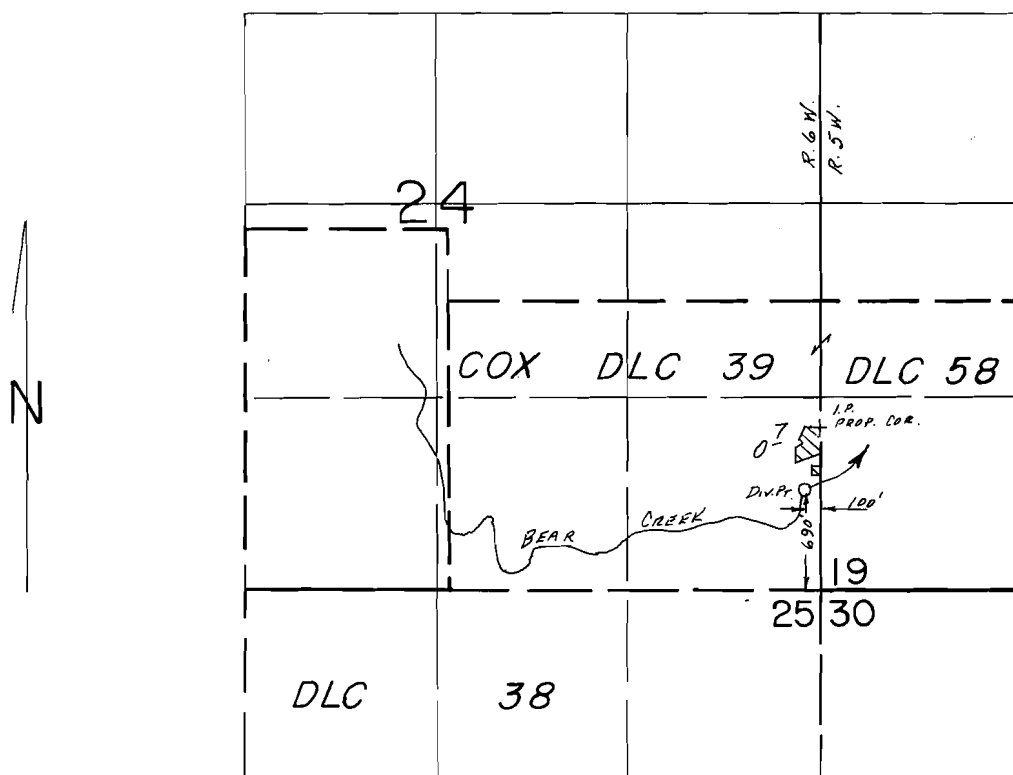

SCALE: 1" = 1320'

FINAL PROOF SURVEY

UNDER

Application No. 59883, Permit No. 45191.....
IN NAME OF

EULA JEAN AMES

Surveyed Nov. 17, 1983, by P. PATER

BWB