


# T.10&11S., R.3W., W.M.

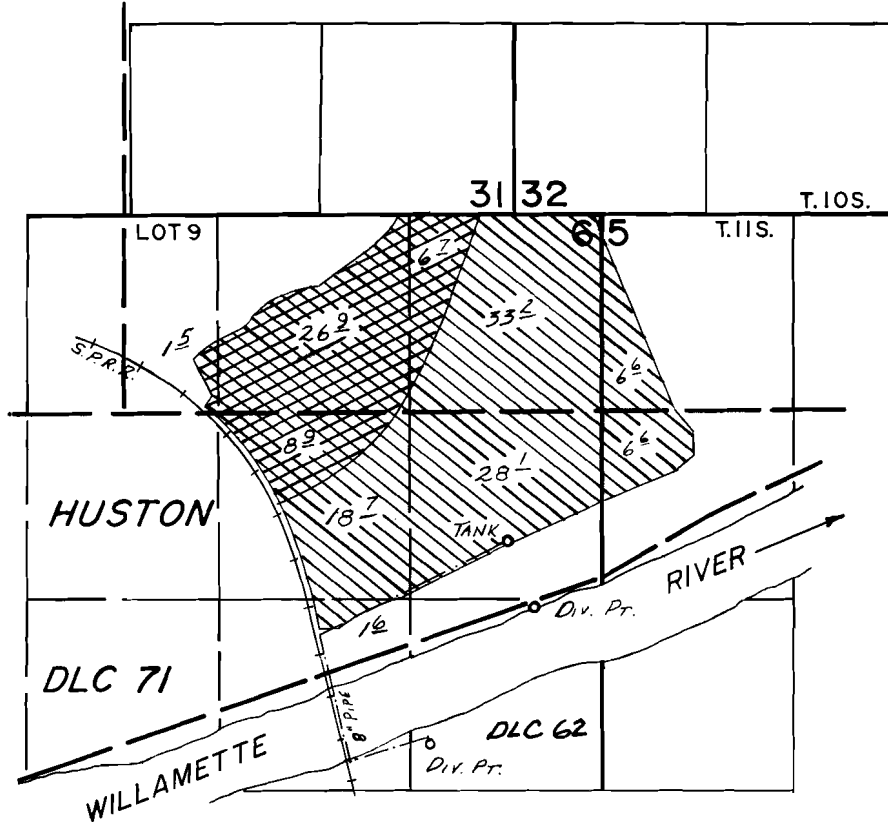

DIV. PTS. LOC. - RIVER 2700'S. & 470'W., WASTE WATER 3650'S. & 1180'W., BOTH FROM NE COR. SEC. 6.


## FINAL PROOF SURVEY UNDER

59923

45687



Application No. 61758... Permit No. 46227...

 

IN NAME OF

C. H. TRACY

Surveyed JULY 27, 1982, by L. M. TOLL