


T.10&11S., R.3W., W.M.

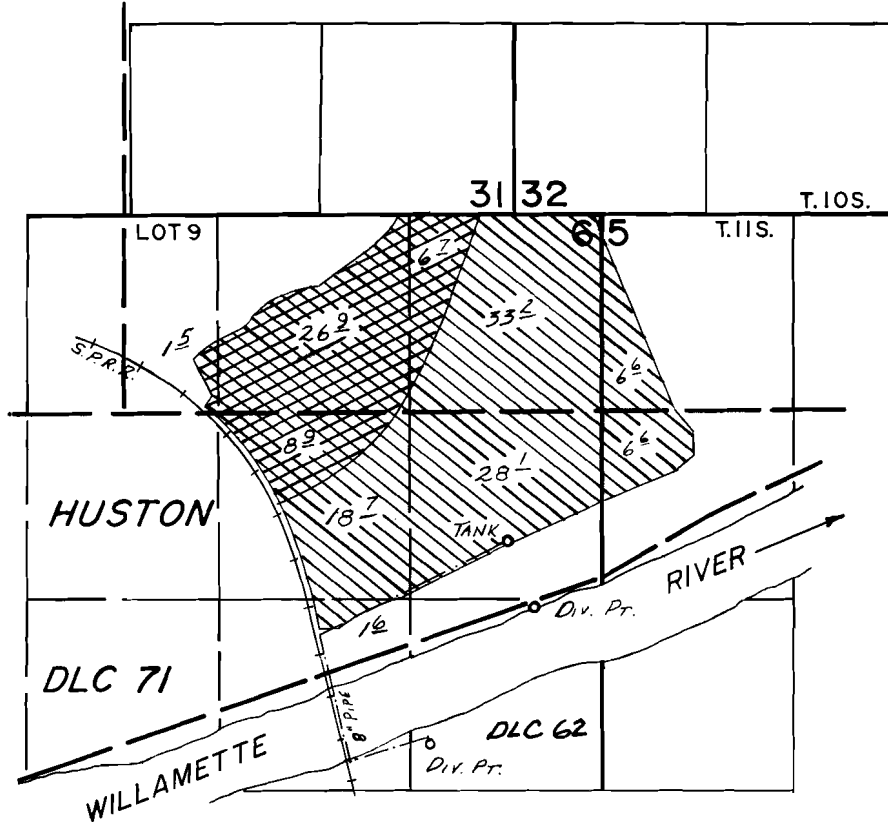

DIV. PTS. LOC. - RIVER 2700'S. & 470'W., WASTE WATER 3650'S. & 1180'W., BOTH FROM NE COR. SEC. 6.

FINAL PROOF SURVEY UNDER

59923 45687 
 Application No. 61758... Permit No. 46227... 

IN NAME OF

C. H. TRACY

Surveyed JULY 27, 1982, by L. M. TOLL