
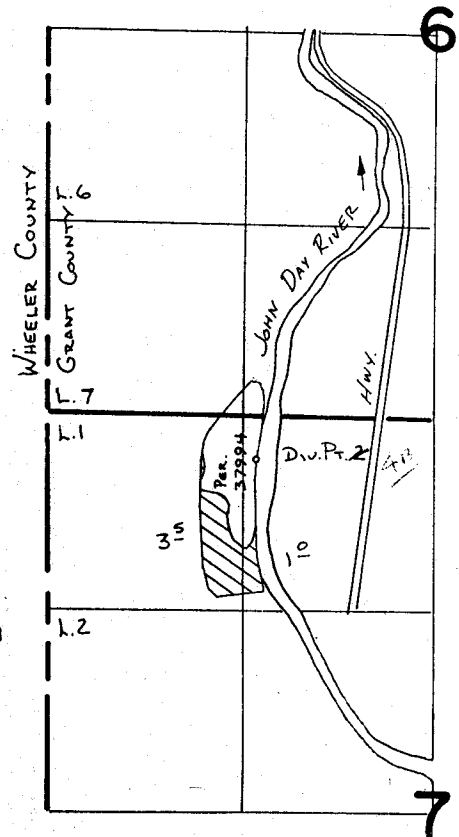


P-45210
C-64680

T. 10S., R. 26E., W.M.

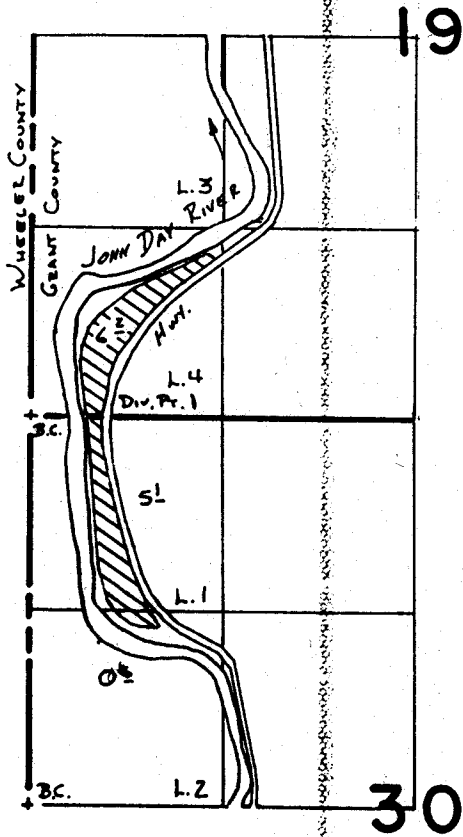

SCALE 1" = 1320'

Div. Pt. 1 Loc: 10' N. & 370' E. FROM SW COR. SEC 19

Div. Pt. 2 Loc: 300' S. & 1440' E. FROM NW COR. SEC. 7

FINAL PROOF SURVEY
UNDER

Application No. **59924** Permit No. **45210**
IN NAME OF

SAM - BAR RANCH

Surveyed **3-18**..... 19**86**, by **V.L. Church**.....

DOV-4JJ-228
28L 29L

V.L.C.