


RECEIVED

AUG 12 1981

WATER RESOURCES DEPT
SALER CHECKOW

T.14S. R.9E. W.M.

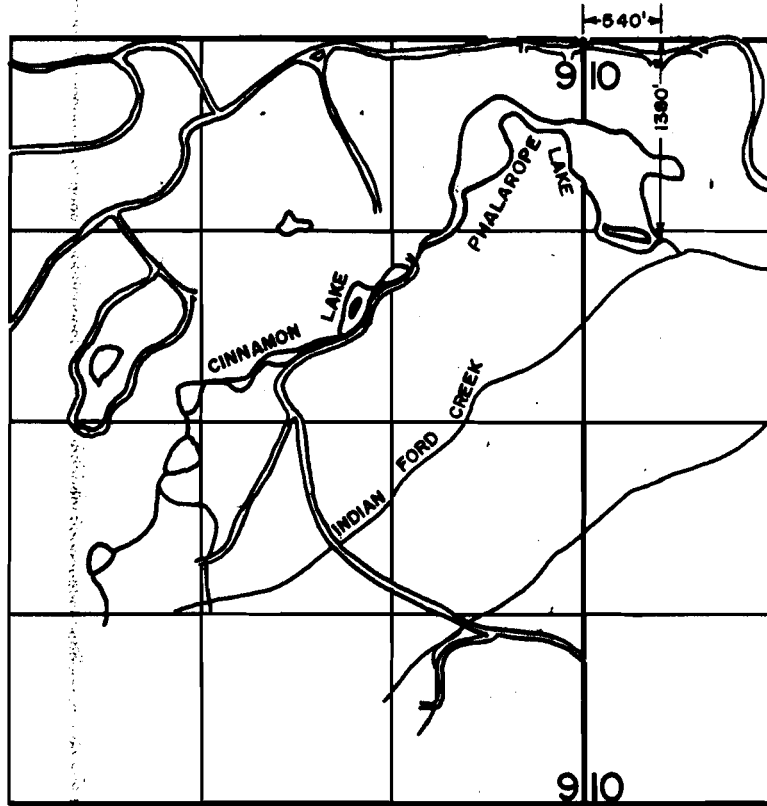

FINAL PROOF SURVEY
UNDER

60029

45644

Feet. 64681

Application No. R-60030 Permit No. R-8253.....

cont. 64682

IN NAME OF

.....**BROOKS RESOURCES CORP.**.....

Surveyed MAR. 21... 1981..., by L.H. NUNN.....

Checked AUG. 11 1981, by L.H. NUNN