


T. 37 S., R. 14 W., W. M.

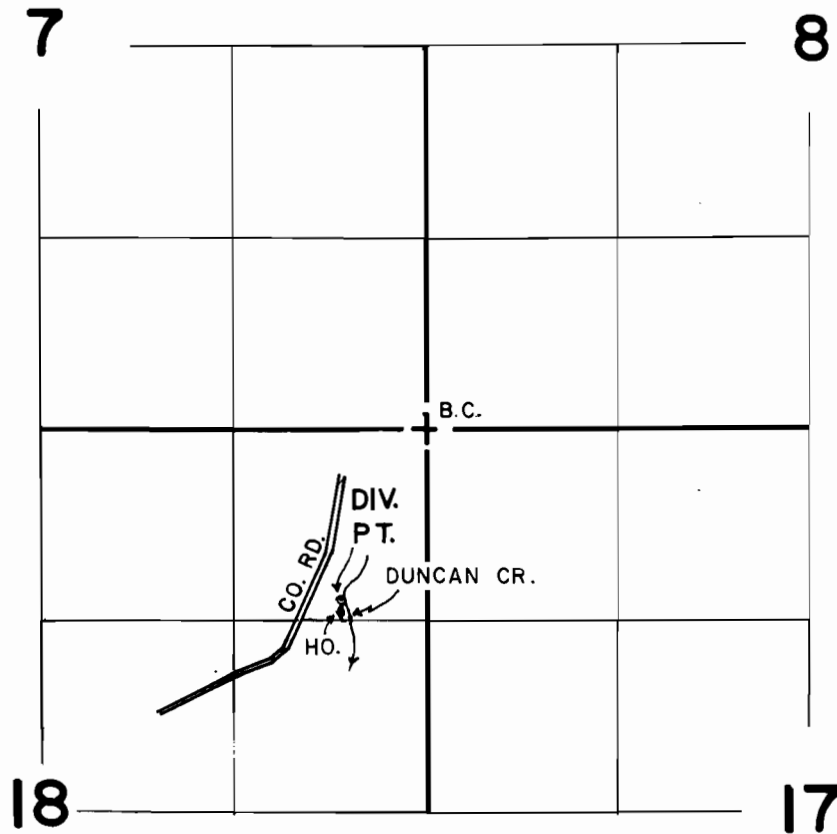

DIV. PT. LOCATED 1160' S. & 590' W. FROM NE COR. SEC. 18.

SCALE: 4" = 1 MILE

FINAL PROOF SURVEY
UNDER

Application No. 60140 Permit No. 46182
IN NAME OF

LEWIS H. & AUDREY M. SMITH

Surveyed SEP. 24, 1985, by J. M. SCHMORDE