


T.22S., R.5 W., W.M.



M. N
 GOODELLS
 D. L. C. 40

LOT 5 & FRACTIONAL LOTS 6 & 7 IN
 IN BLOCK 5 OF GARDNER'S ADDITION TO
 THE CITY OF DRAIN.

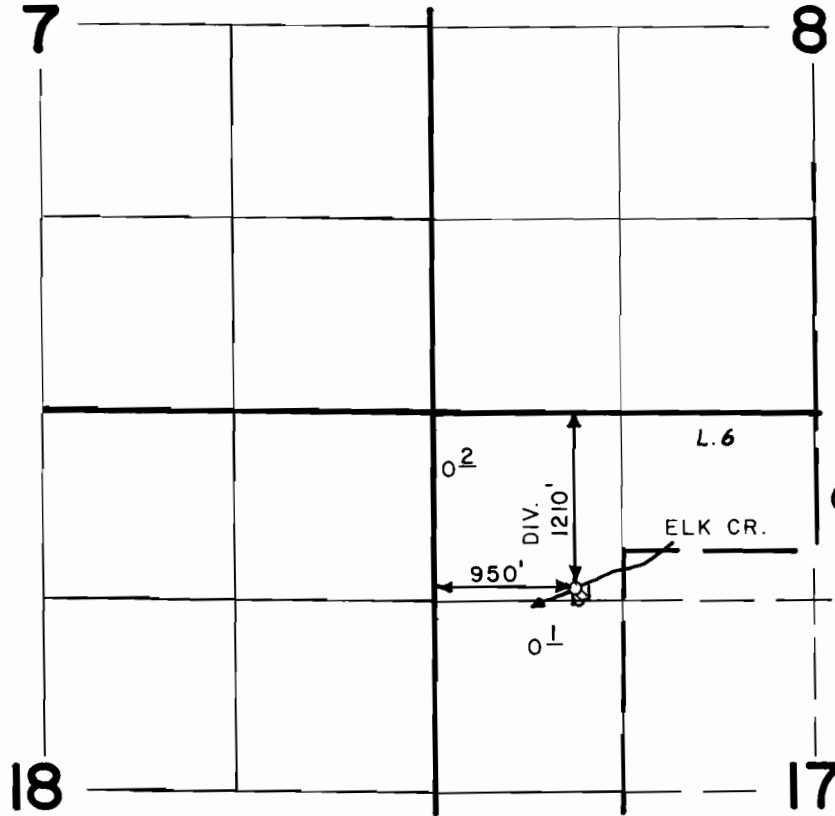

SCALE: 4" = 1 MILE

FINAL PROOF SURVEY UNDER

Application No. 60203 Permit No. 45145
 IN NAME OF

JAMES EARL & MARILYN JOYCE DAVIS

Surveyed OCT. 20 1986, by J.M. SCHMORDE