


T.30S., R.4W., W.M. SECTION 21

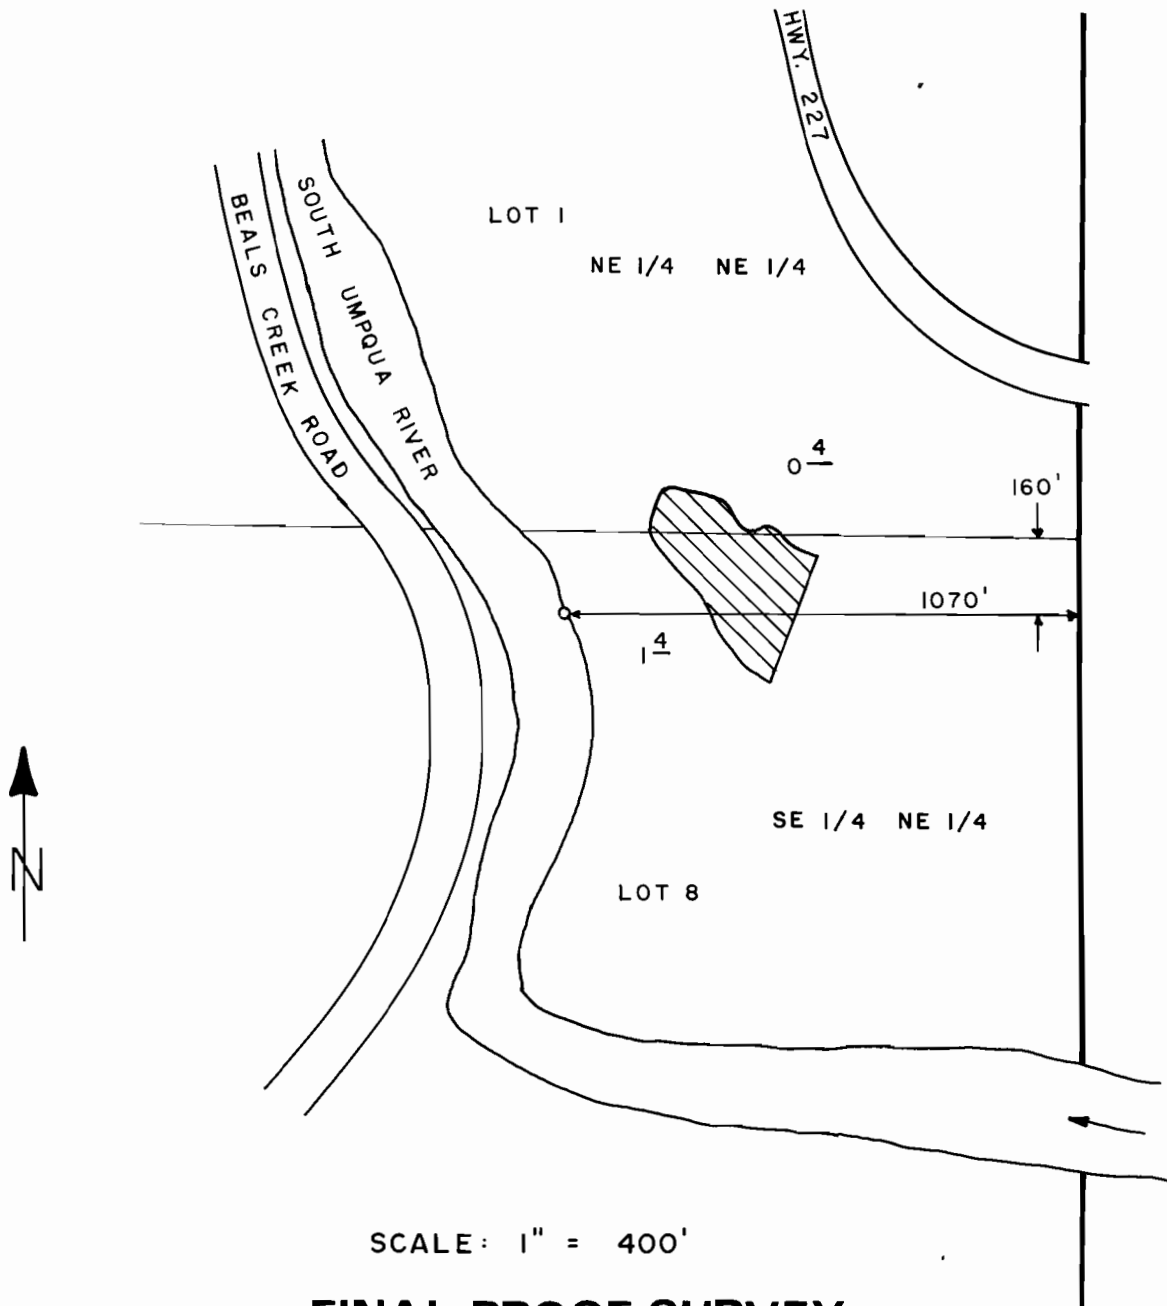

SCALE: 1" = 400'

FINAL PROOF SURVEY UNDER

Application No. 60253 Permit No. 45147
IN NAME OF

GEORGE V. DAVIS

Surveyed OCT. 5, 1986, by J. M. SCHMORDE