


T. 40 S., R. 4 W., W.M.

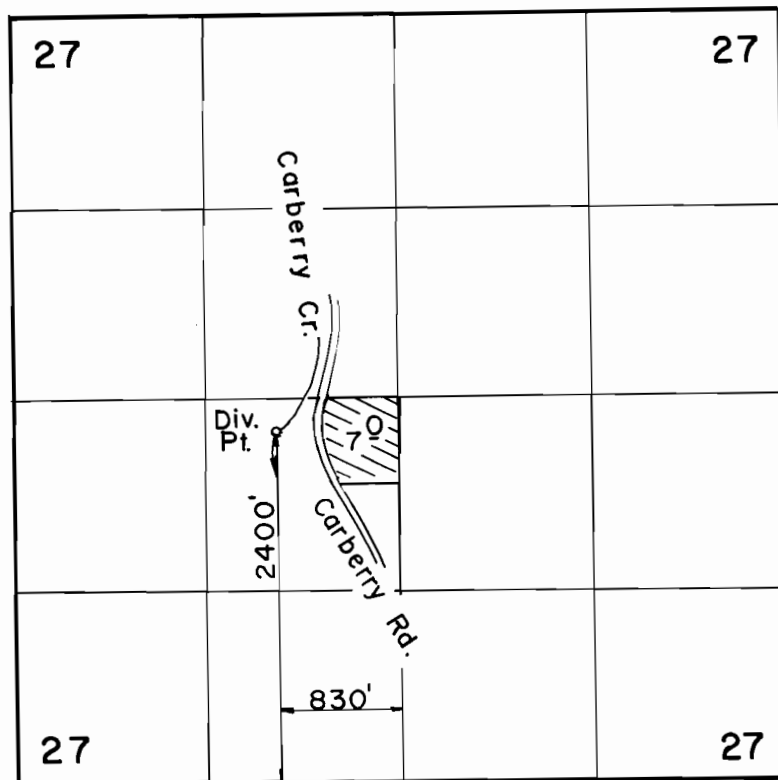

Scale: 1" = 1320'

FINAL PROOF SURVEY UNDER

Application No. **60255** Permit No. **45131**.....
IN NAME OF

JAY ...W.....**8**/OR.....**JANICE**.....**A**.....**COOPER**

Surveyed NOV...2... 1987, by B.....S.....**JAMES**.