


T. 25 S., R. 6 W., W.M.
SECTION 13

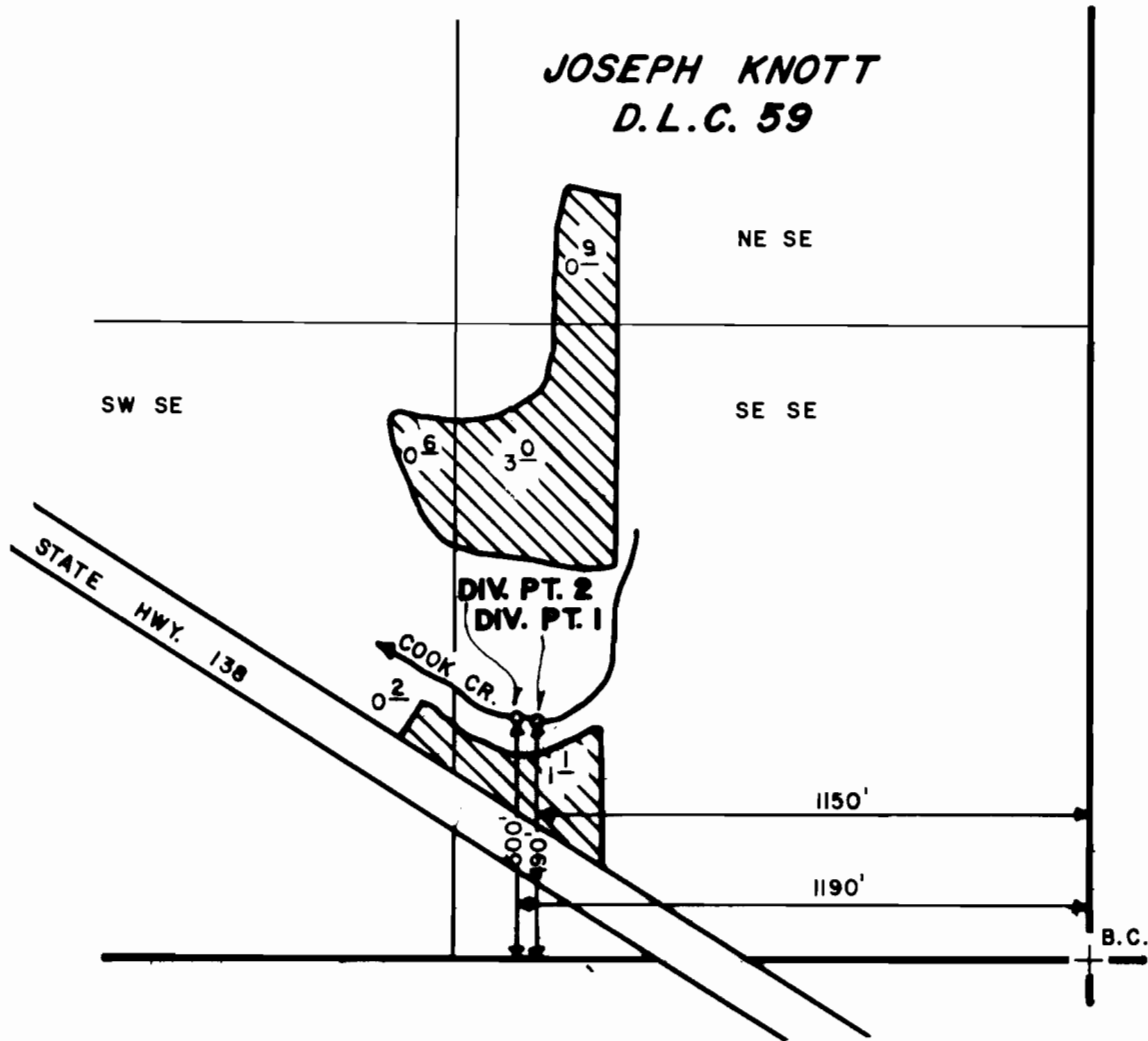

SCALE 1" = 400'
FINAL PROOF SURVEY
UNDER

Application No. **60448** Permit No. **45255**
IN NAME OF

LAURA TABOR

Surveyed **JULY 10**, 19**86**, by **J. M. SCHMORDE**