


T. 28S., R. 6W., W.M.

SECTIONS 3 & 4

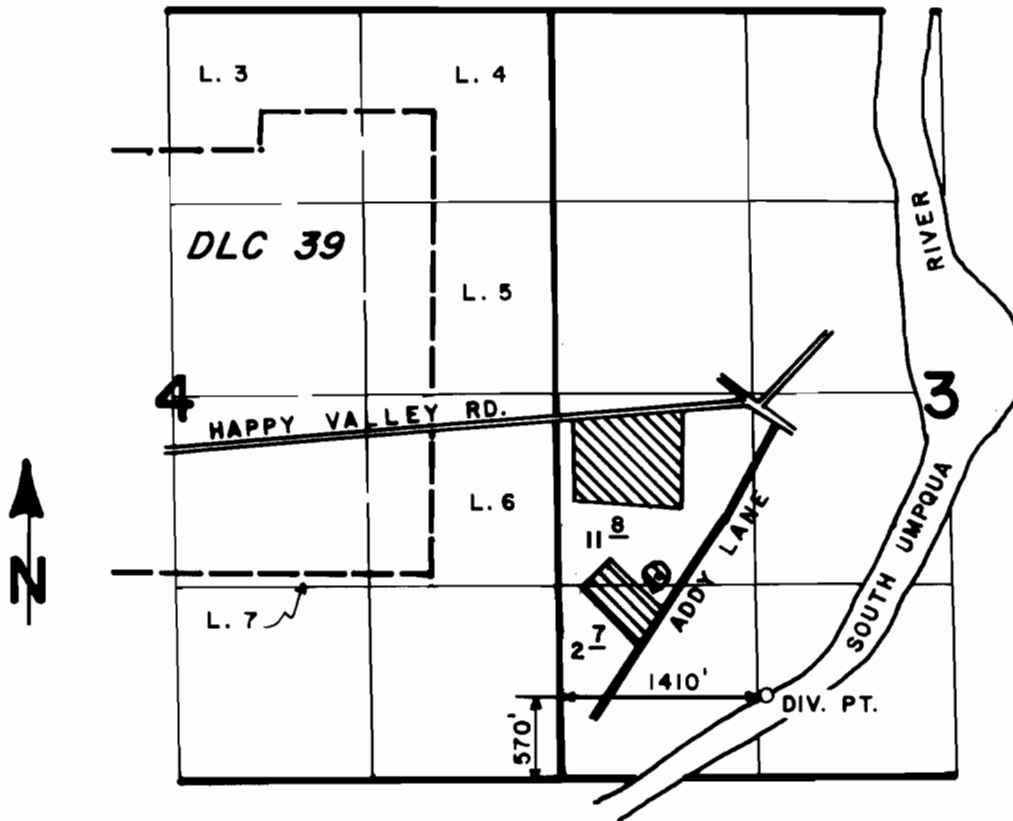

SCALE: 4" = 1 MILE

FINAL PROOF SURVEY
UNDER

Application No. 60456 Permit No. 45257
IN NAME OF

ORVILLE & DARLENE CASEY

Surveyed MAY 7, 1987, by J.M. SCHMORDE