


T. 27S., R. 5W., W.M.

SECTIONS 2 and 3

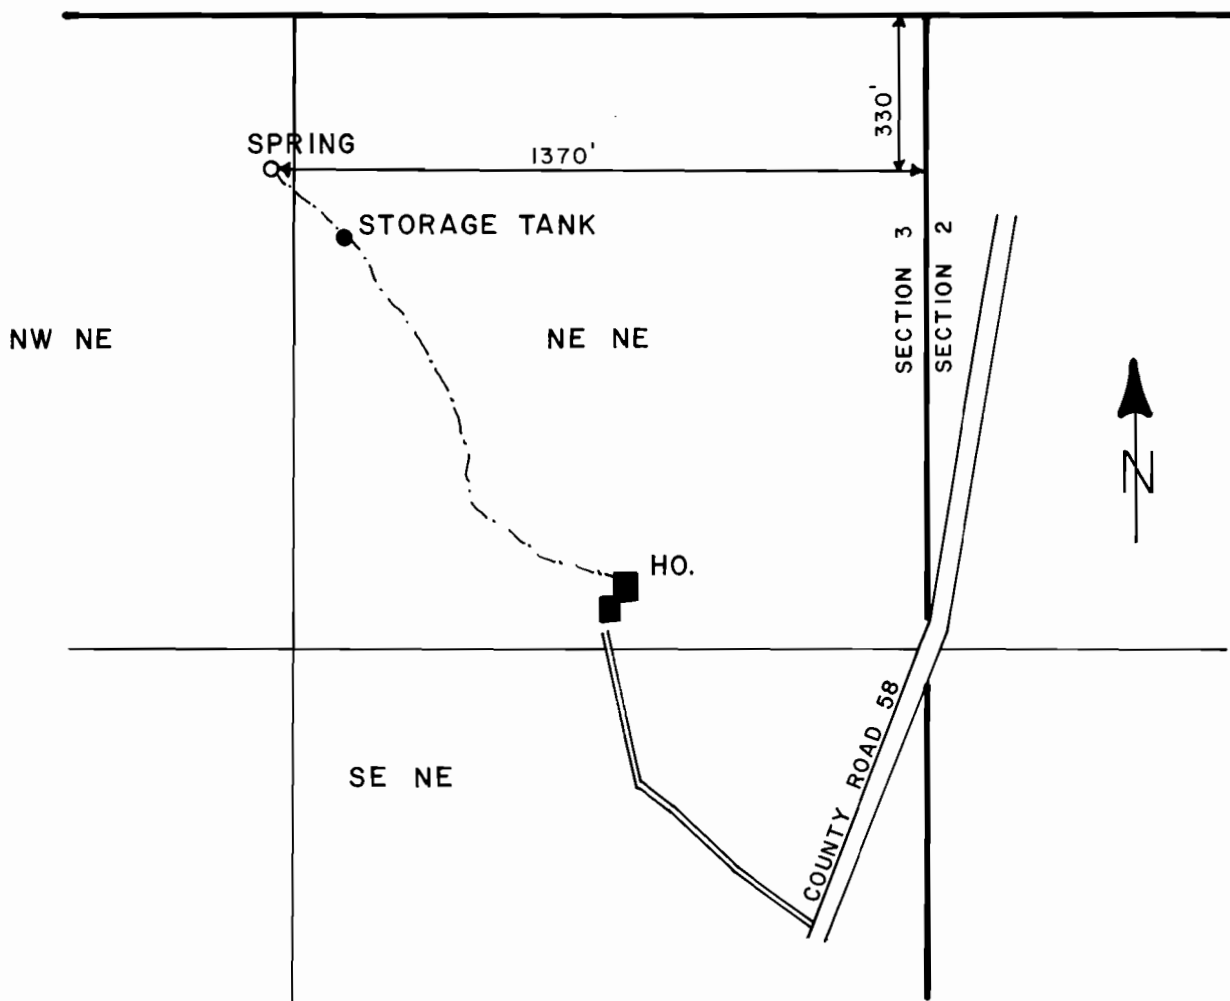

SCALE: 1" = 400'

FINAL PROOF SURVEY
UNDER

Application No. 60813 Permit No. 45396
IN NAME OF

MICHAEL E. DUNN

Surveyed OCT. 26, 1987, by J. M. SCHMORDE