



# T. 29S., R. 4 W., W.M. SECTION 18

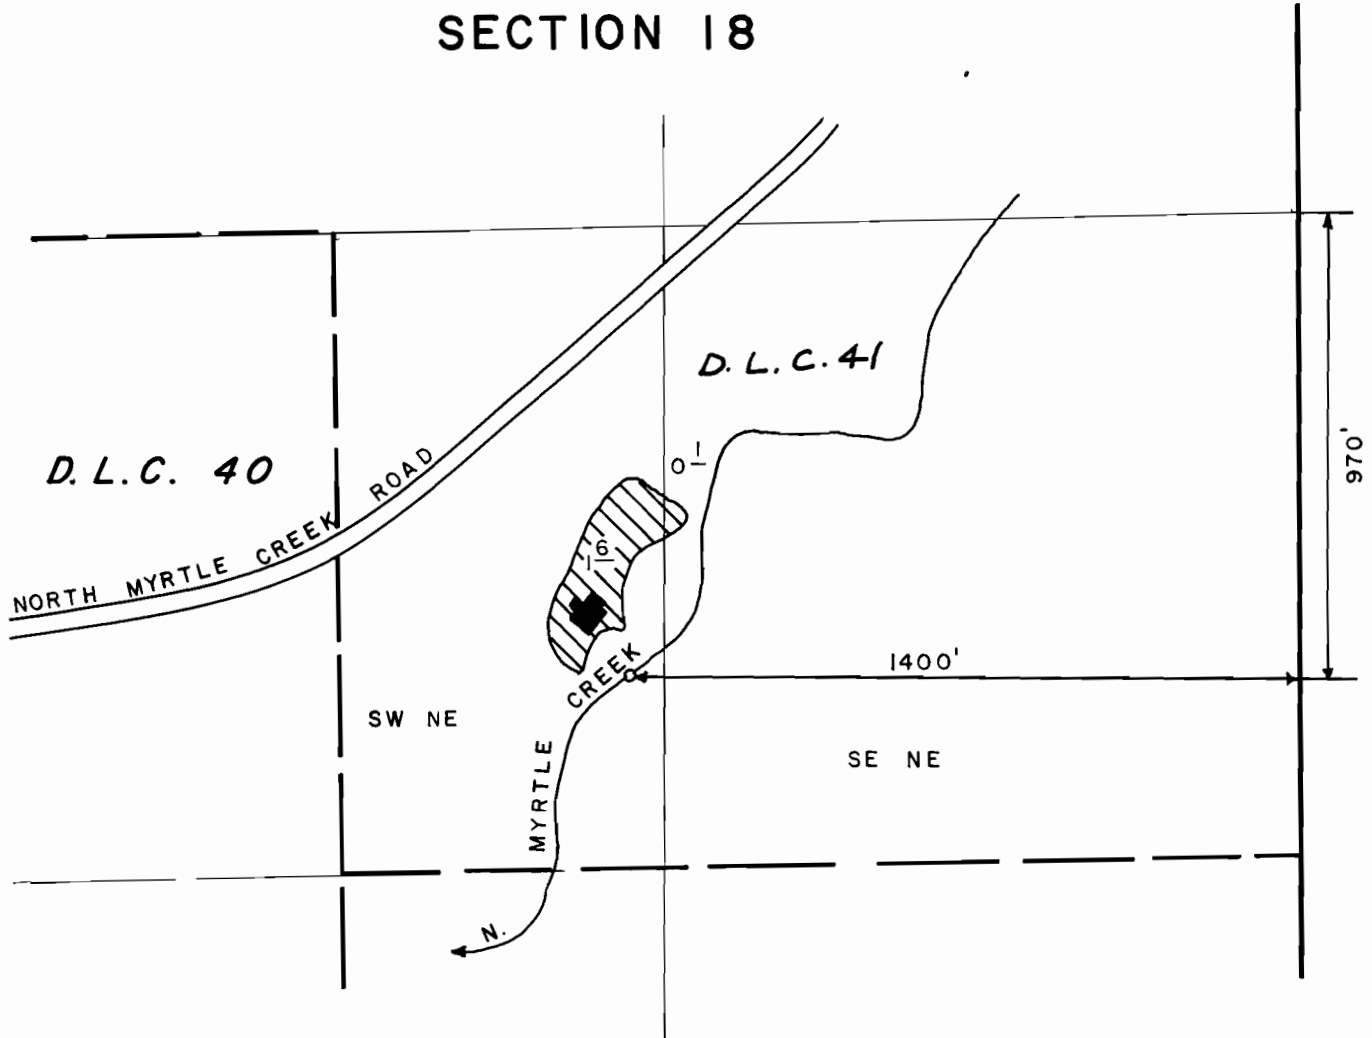

SCALE: 1" = 400'

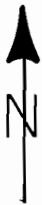

## FINAL PROOF SURVEY UNDER

Application No. 60910 Permit No. 45401  
IN NAME OF

**STEVEN G. PETERMAN**

Surveyed MAY 15, 1986, by J. M. SCHMORDE