



T. 33 S., R. 2 E., W. M.

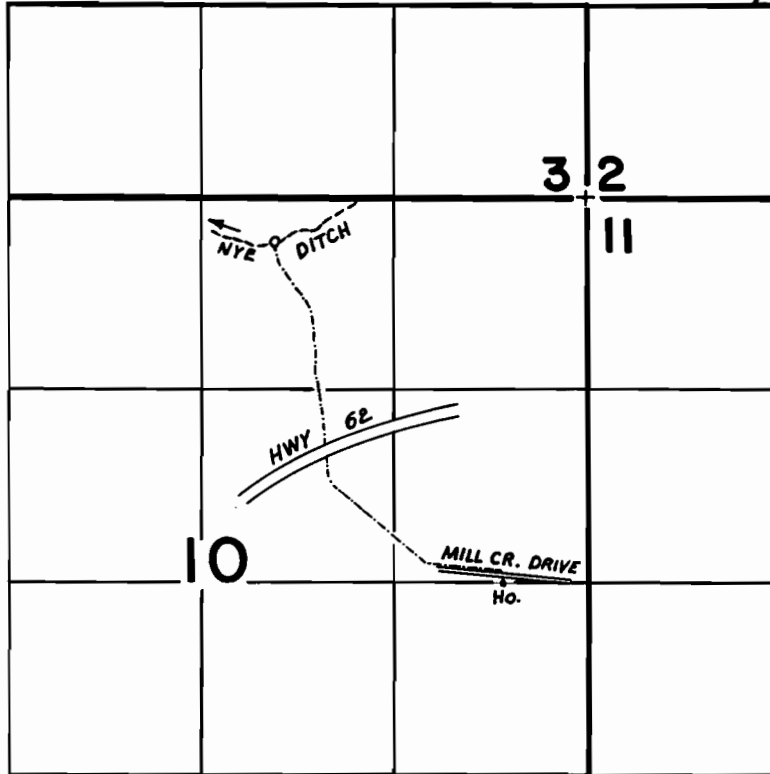

SCALE: 1" = 1320'

T. 32 S., R. 3 E., W. M.

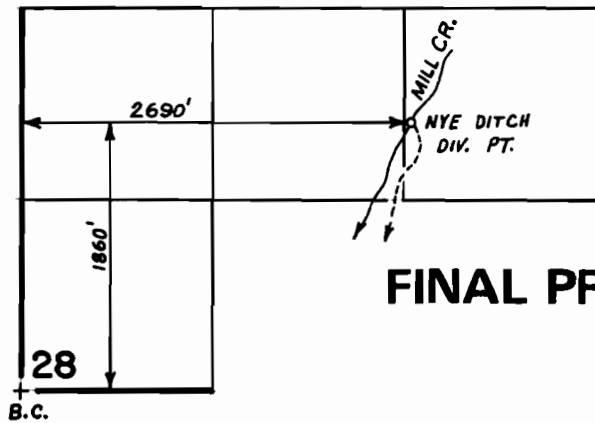

FINAL PROOF SURVEY
UNDER

Application No. 60937 Permit No. 45315
IN NAME OF

JAMES W. HAVSTAD

Surveyed MAY 25 1983, by B. S. JAMES